

JACKSON

N 74

Abandoned

WATER WELL DRILLERS LOG

~~W 35~~

8-8-60

Date: 8-8, 1960, Driller: C.T. Surtzger Well Co County Jackson
35 (Name)

(1) Owner of Land: Coast Waterworks, Inc.
Gulf Pine (Name) Subdivision
Ocean Springs, Miss. (Address)

(2) Location: 1/4, N 1/4, Sec. 28 T 75 R 84
1/4 miles E, of Ocean Springs
 (distance) (direction) (Nearest Town)

(3) Topography: (Hilly) (Flat) (Level)

(4) Purpose of Well: Domestic
 (Domestic Irrigation, Municipal, Industrial, Other)

| Description & Color of Materials Sand, Clay, Red Clay, Shell, etc. | Thick- ness Feet | Depth Feet |
|---|------------------------|---------------|
| Clay | 0 | 12 |
| Sand | 12 | 19 |
| Clay | 19 | 27 |
| Sand | 27 | 27 |
| Clay sand streaks | 27 | 87 |
| Clay | 87 | 131 |
| Sand - fair | 131 | 141 |
| Clay | 141 | 175 |
| Clay sand streaks | 175 | 220 |
| Clay | 220 | 243 |
| Clay sand streaks | 243 | 281 |
| Clay | 281 | 309 |
| Clay sand streaks | 309 | 376 |
| Clay sand streaks | 376 | 399 |
| Sand | 399 | 414 |
| Clay | 414 | 450 |
| sand fair | 450 | 465 |
| sand good | 465 | 508 |
| sand - water good | 508 | 525 |

Information upon completion of well:

(1) Diameter 12 X 8 inches.

(2) Total Depth 525 feet.

(3) Water Level -15' feet below top of ground.


(4) Cased to 525', Size 12 X 8.

(5) Screen: Size 10 ga. SS, Length 40' X 8".

(6) Were any formations sealed against pollution?
 yes, no.

If YES depth of formation 10 feet
 Why Health dept. requirement

Drillers Remarks:

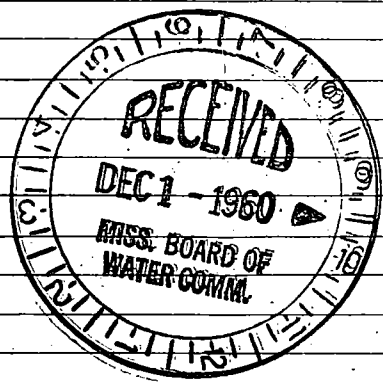

508
10
285

(Use Back Side)

Well No.

