

JACKSON

N 81

WATER WELL DRILLERS LOG



Date: 8-15-60 Aug. 15, 1960, Driller: L. L. Garland County Jackson
 35 (Name)


(1) Owner of Land: Gulf Park Estates
 (Name)
Ocean Springs, Miss.
 (Address)
 (2) Location: SE 1/4, NW 1/4, Sec. 11 T85R8W
3 1/2 miles East of O.S.
 (distance) (direction) (Nearest Town)
 (3) Topography: Flat
 (Hilly) (Flat) (Level)
 (4) Purpose of Well: Domestic
 (Domestic Irrigation
 Municipal, Industrial, Other)

Description & Color of Materials Sand, Clay, Red Clay, Shell, etc.	Thick- ness Feet	Depth Feet
Red Clay	8	0-8
Sand	34	42
Blue Clay	63	42-105
" " Sand	42	
Sand	42	
Mixed	21	
Blue Clay	42	
Mixed	21	
Blue Clay	21	
Mixed	42	
Blue Clay	84	
Sand	17	
Blue "	46	
Sand	10	
Hard Clay & Shale	53	
Sand (Fine)	21	
Hard Clay	73	
Hard Shale & Rock	84	
Mixed	105	
Blue Clay	63	
Sand (Good)	43	

Information upon completion of well:

(1) Diameter 2 inches.
 (2) Total Depth 935 feet.
 (3) Water Level Flow feet below top of ground.
 (4) Cased to _____, Size _____
 (5) Screen: Size 2" - .08, Length 20'
 (6) Were any formations sealed against pollution?
 _____ yes, _____ no.

If YES depth of formation _____
 Why _____
 Drillers Remarks: _____

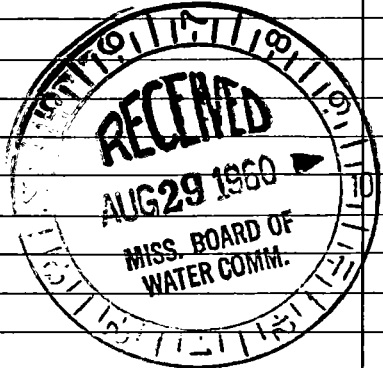

(Use Back Side)

Well No.

