

TALK 500
N 90
4-66

MISSISSIPPI BOARD OF WATER COMMISSIONERS

E LOG # 165

WATER WELL DRILLERS LOG

CODED

Date: 4-8-66, 1966, Driller: C. T. Surtzow Well Co. County Jackson
(Name)

(1) Owner of Land: Coast Waterworks Inc
Wood Haven Sub - division
Highway 90 Ocean Springs
(Name)
(Address)


(2) Location: 1/4, 1/4, Sec. 28 T7 R8
_____ miles _____ of _____
(distance) (direction) (Nearest Town)

(3) Topography: X
(Hilly) (Flat) (Level)

(4) Purpose of Well: Commercial
(Domestic Irrigation
Municipal, Industrial, Other)

Description & Color of Materials Sand, Clay, Red Clay, Shell, etc.	Thick- ness Feet	Depth Feet
Sand	0	15
Clay	15	19
Sand	19	49
Clay	49	64
Mixed sand & clay	64	87
Clay	87	101
Sand	101	122
Mixed	122	129
Clay	129	156
Sand	156	164
Clay	164	185
Sand	185	192
Clay	192	197
Sand, streaks	197	208
Clay	208	265
Shell	265	275
Clay	275	295
Mixed	295	299
Sand	299	304
Clay	304	329
Hard Clay	329	348
Clay	348	363
Sand	363	370
Sand, fair	370	380
Mixed	380	408
Clay	408	457
Sand	457	462
Sand, fair	462	485
Sand	485	508
Sand, good	508	522
Rock mixed	522	529
Sand, good	529	547

CODED

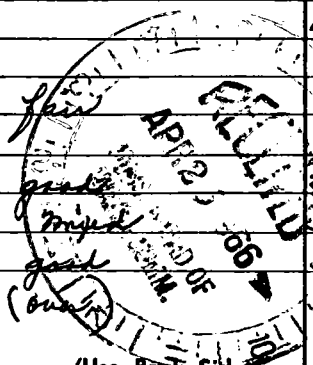

Information upon completion of well:

(1) Diameter 8" x 12" inches.

(2) Total Depth 565' feet.

(3) Water Level 10' - feet below top of ground.

(4) Cased to 565', Size 8" x 12"
top 160-12"

(5) Screen: Size 8 gals, Length 20'
split 40' - 8 gals
10' - 10 gals
20' - 8 gals

(6) Were any formations sealed against pollution?
X yes, _____ no.

If YES depth of formation _____

Why _____

Drillers Remarks: Health Dept Permits

(Use Back Side)

Well No.

Sand 547-565 (set)
Clay 565 - 829
Sand 829- 834
Clay 834 - 858
Hard Clay 858 - 879
Mixed 879- 889
Clay 889 - 901
Mixed shale 901 - 924
Mixed 924 - 946