

N 91

E Log # 166

WATER WELL DRILLERS LOG

**CODED**

Date: 12-15-65 19, Driller: C. T. Surtz Well County Jackson  
(Name)

(1) Owner of Land: Coast Waterworks Inc  
(Name)  
Fort Bayou Estates Sub-div  
(Address) ? 15

(2) Location: 1/4, 1/4, Sec. 22 T 7 R 8,  
\_\_\_\_\_ miles \_\_\_\_\_ of \_\_\_\_\_  
(distance) (direction) (Nearest Town)

(3) Topography:  (Hilly)  (Flat)  (Level)

(4) Purpose of Well: Commercial  
(Domestic Irrigation  
Municipal, Industrial, Other)

Description & Color of Materials Sand, Clay, Red Clay, Shell, etc.	Thick- ness Feet	Depth Feet
Clay	0	5
Sand	5	18
Mixed sand	18	26
Clay	26	41
Mixed	41	53
Sand	53	63
Clay	63	75
Sand	75	88
Clay	88	109
Sand	109	121
Clay	121	141
Sand	141	147
Clay	147	209
Sand	209	214
Clay	214	219
Sand	219	234
Clay	234	263
Mixed sand + clay	263	285
Clay	285	290
Sand	290	300
Clay	300	308
Sand streaks	308	329
Clay	329	382
Sand	382	496

**CODED**

Information upon completion of well:

(1) Diameter 12x8 inches.

(2) Total Depth 496' feet.

(3) Water Level -12' feet below top of ground.  
top 160 ft 12"

(4) Cased to 496 , Size 4 1/2 ft 8"  
436?


(5) Screen: Size 10 ga , Length 60'

(6) Were any formations sealed against pollution?  
 yes, \_\_\_\_\_ no.

If YES depth of formation \_\_\_\_\_

Why Health Dept Requirements

Drillers Remarks: \_\_\_\_\_

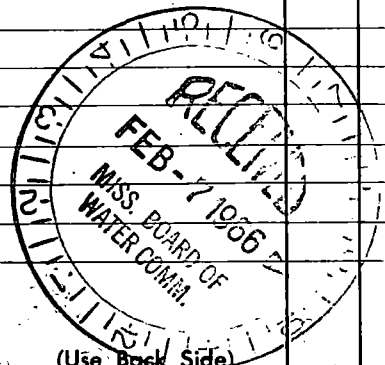

Well No. \_\_\_\_\_

(Use Back Side)

1940