


If well telescopes please sketch and show depths.

On Big Ridge Rd. in Jackson Co.
3/4 mi. E of county line.

GROUND LEVEL

↑
N

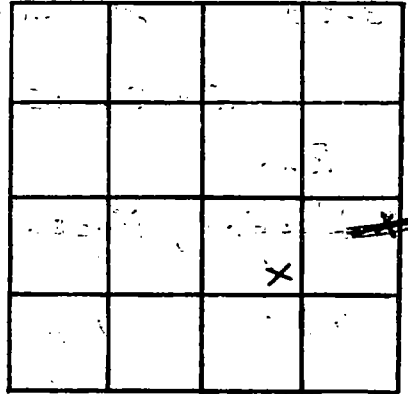

SECTION 910

Please indicate well location X.

ADDITIONAL INFORMATION

If more than one screen,
show locations of each on sketch.