

JACKSON  
 N 95  
 10-67  
 U.S.G.S

MISSISSIPPI  
 BOARD OF WATER COMMISSIONERS  
 416 North State Street  
 Jackson, Mississippi 39201

WATER WELL DRILLERS LOG

10-9 1967 Switzer Well Co. Jackson  
 date well completed firm name county well located

LANDOWNER: Upton Harties  
Coast Waterworks  
Cedar Grove Subdivision  
Biloxi, Mississippi  
 (mailing address)

description of formations encountered	from	to
clay	0	5
sand	5	24
sand + clay	24	36
sand	36	48
clay	48	220
sand	220	228
clay	228	276
shale	276	310
clay	310	471
sand	471	483
sand + clay streaks	483	518
clay	518	541
fine sand	541	599
fine sand	599	641


WELL LOCATION:  
 sec. 10 T. 7 S. R. 9 W.  
3 miles NE of BILOXI  
 (distance) (direction) (nearest town)

WELL PURPOSE: SUBDIVISION  
 (home, irrigation, municipal, industrial)

WELL COMPLETION DATA:


- (1) diameter (inches) 6 x 8
- (2) total depth (feet) 599
- (3) static water level (feet) 25 below top of ground.
- (4) casing gal. steel 539'  
 (material) (depth)  
6 x 8 if telescope see back.  
 (size)
- (5) screen 60' 539'  
 (length) (depth to top)  
8 ga. SS on pipe  
 (size) (material)
- (6) pump 20 250  
 (HP) (yield gpm)  
electric  
 (type power)
- (7) electric log Yes  
 (yes or no)  
U.S.G.S.  
 (organization running log)
- (8) how well bottom plugged Back  
pressure valve

DRILLERS REMARKS:

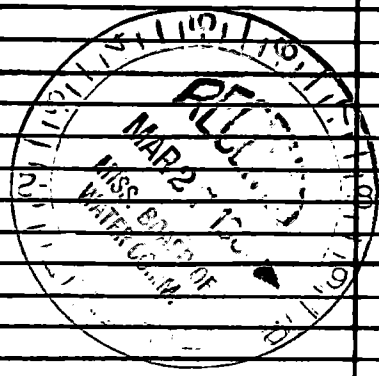

If well telescopes please sketch and show depths.

GROUND LEVEL

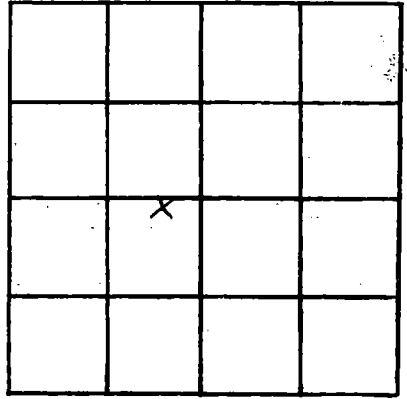

SECTION 10

Please indicate well location X.

ADDITIONAL INFORMATION

A series of horizontal lines for writing additional information, starting below the 'ADDITIONAL INFORMATION' header and extending to the bottom of the page.

If more than one screen, show locations of each on sketch.