

JACKSON MISSISSIPPI BOARD OF WATER COMMISSIONERS

N 98

WATER WELL DRILLERS LOG

6-9-60

Date: June 9, 1960, Driller: C.S. Switzer Well Co. County Jackson
 45 (Name)

(1) Owner of Land: M.O. Gerice
P.O. Box 195, Ocean Springs
N. of Gulf Hills Entrance
300 gulf hills av (Address)

(2) Location: ET 1/4, NW 1/4, Sec. 19 T75R8W
1/2 miles N of Ocean Springs
 (distance) (direction) (Nearest Town)

(3) Topography: (Hilly) (Flat) (Level)

(4) Purpose of Well: domestic
 (Domestic Irrigation
 Municipal, Industrial, Other)

Description & Color of Materials Sand, Clay, Red Clay, Shell, etc.	Thick- ness Feet	Depth Feet
<u>Mixed</u>		<u>34</u>
<u>sand</u>	<u>34</u>	<u>66</u>
<u>Stratified sand</u>	<u>66</u>	<u>84</u>
<u>fine sand</u>	<u>84</u>	<u>126</u>
<u>stratified sand</u>	<u>126</u>	<u>147</u>
<u>Clay</u>	<u>147</u>	<u>223</u>
<u>fine sand</u>	<u>223</u>	<u>234</u>
<u>Clay</u>	<u>234</u>	<u>265</u>
<u>sand</u>	<u>265</u>	<u>277</u>
<u>Clay</u>	<u>277</u>	<u>410</u>
<u>stratified sand</u>	<u>410</u>	<u>453</u>
<u>Good sand</u>	<u>453</u>	<u>472</u>

Information upon completion of well:

(1) Diameter 2" inches.

(2) Total Depth 472 feet.

(3) Water Level 15' feet below top of ground.

(4) Cased to 472', Size 2"
10' clayton


(5) Screen: Size 1/8", Length 10'
8 slot

(6) Were any formations sealed against pollution?
 yes, no.

If YES depth of formation 10 feet

Why Health dept. requirement

Drillers Remarks:

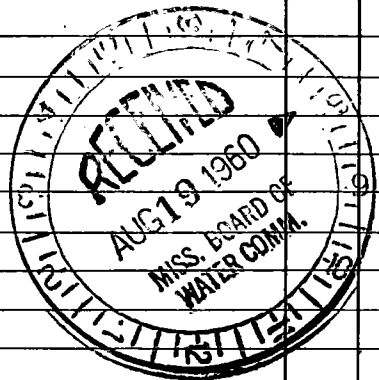

(Use Back Side)

Well No.

Project Report: [Illegible Title]

Date	Description	Status
2023-10-01	Initial meeting with stakeholders.	Completed
2023-10-05	Review of project requirements.	In Progress
2023-10-10	Development of project plan.	Not Started
2023-10-15	Assignment of team members.	Completed
2023-10-20	Start of development phase.	In Progress
2023-10-25	Regular team meetings.	Ongoing
2023-11-01	Review progress and adjust plan.	Completed
2023-11-05	Final testing and deployment.	Not Started
2023-11-10	Post-project evaluation.	Not Started

How to perform tasks more effectively?

1. Prioritize tasks based on importance and urgency.
2. Break large tasks into smaller, manageable chunks.
3. Use time management techniques like the Pomodoro method.

For the report, use the following structure:

1. Introduction
2. Background
3. Methodology
4. Results
5. Conclusion

Facultory and other related information.

1. Introduction
2. Background

3. Methodology
4. Results

5. Conclusion
6. References

7. Appendix