

N 100

N 303

WATER WELL DRILLERS LOG

7-11-60

Date: July 11, 1960, Driller: C. J. Switzer Well Co. County Jackson
(Name)

(1) Owner of Land: Gilbert Stalman
Old Highway 90 (Name) East of Indian
Millage (Address)

(2) Location: 1/4, 1/4, Sec. 34 T 75 R 8
3 miles E of Ocean Springs
(distance) (direction) (Nearest Town)

(3) Topography: (Hilly) (Flat) (Level)

(4) Purpose of Well: Domestic
(Domestic Irrigation Municipal, Industrial, Other)

Description & Color of Materials Sand, Clay, Red Clay, Shell, etc.	Thick- ness Feet	Depth Feet
Surface Clay	24	24
Sand & Gravel (white sand)	81	105
Blue clay	8	113
Sand-Fine (white sand)	30	143
Blue clay	75	218
Clay & sand streaks (fine)	66	284
Clay	9	393
Coarse sand	18	411


Information upon completion of well:

- (1) Diameter 2 inches.
- (2) Total Depth 411 feet.
- (3) Water Level 2 1/2' - feet below top of ground.
- (4) Cased to 411', Size 2"
- (5) Screen: Size .010.00 Length 10'
- (6) Were any formations sealed against pollution?
 yes, no.

If YES depth of formation 10 feet

Why Health dept. requirement

Drillers Remarks:

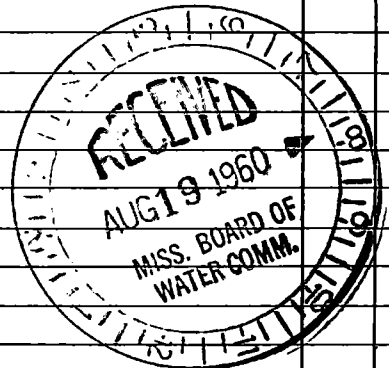

(Use Back Side)

Well No.

11
 12
 13
 100