

JACKSON

MISSISSIPPI BOARD OF WATER COMMISSIONERS

N 102

WATER WELL DRILLERS LOG

8-19-60

Date: Aug. 19, 1960, Driller: Joseph D. Milh County Jackson

(Name)

(1) Owner of Land: OR. Speers

(Name)

Pearl Springs

(Address)

(2) Location: 1/4, NW 1/4, Sec. 33 T75R8W

4 miles S-E, of Pearl Springs

(distance)

(direction)

(Nearest Town)

(3) Topography: Flat

(Hilly)

(Flat)

(Level)

(4) Purpose of Well: Domestic

(Domestic Irrigation
Municipal, Industrial, Other)

Information upon completion of well:

(1) Diameter 2 inches.

(2) Total Depth 578 feet.

(3) Water Level 7 1/2 feet below top of ground.

(4) Cased to 568', Size 2"

(5) Screen: Size 2", Length 10'

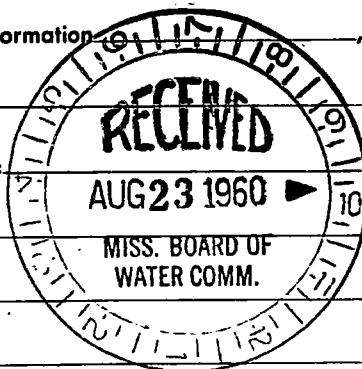
(6) Were any formations sealed against pollution?

yes, no.

If YES depth of formation

Why

Drillers Remarks:

Description & Color of Materials
Sand, Clay, Red Clay, Shell, etc.Thick-
ness
FeetDepth
Feet

Surface Sand.		8
W. Sand.	4	12
Blue Clay	28	40
Cl + Shells	2	42
Gray Clay	10	52
Sand Course	8	60
Red Clay	6	66
Blue Clay	7	73
Gray Sand	17	90
Gray Sand Fine	22	112
Shells & Wood	2	114
Sand Fine	11	125
Sand Gray Fine	40	165
Hard Blue Clay	20	185
Small Break	8	193
Hard Blue Clay	6	199
Small Break	20	219
Small Break & Sand	37	252
Break Fine Sand	10	262
	10	272
Hard Blue Clay	51	323
Fine Gray Sand	24	347
Hard Blue Clay	59	406
Gray Sand Fine	13	419
	9	428
Hard Blue Clay	20	448
Hard Clay	3	451
Sand Gray Sand	11	462
Sand N.C.	3	465
Hard Clay	13	478
Sand Gray Fine	15	493
Sand	21	514

Well No.

(Use Back Side)

Mail this copy to Board of Water Commissioners 429 Miss. St. Jackson, Miss.

10	524 - 534	sand.	Fair
11	- 525	"	Good
21	- 546	"	"
32	- 578	"	Best Good

Still in Coarse sand.

