


JACKSON
N 104

N 12 1/2

WATER WELL DRILLERS LOG

Date: Oct. 7, 1960, Driller: L. L. Garland County Jackson
45 (Name)

(1) Owner of Land: <u>Mr. Maudeline</u> <small>(Name)</small>	Description & Color of Materials Sand, Clay, Red Clay, Shell, etc.	Thick- ness Feet	Depth Feet
<u>Seaman Rd. Ocean Springs</u> <small>(Address)</small>	18' Clay 3' Sand		21
(2) Location: <u>SW 1/4, SE 1/4, Sec. 1 T. 75 R. 9 W.</u>	16' Sand 2' Gravel		42
<u>4</u> miles <u>North</u> of <u>O.S.</u> <small>(distance) (direction) (Nearest Town)</small>	18' Sand 3' Mud		68
(3) Topography: <u>X</u> <small>(Hilly) (Flat) (Level)</small>	21' Mixed		88
(4) Purpose of Well: <u>Domestic</u> <small>(Domestic Irrigation Municipal, Industrial, Other)</small>	13' Sand 7' Mud		105
	21' Mud		126
	Fine Sand & Mud		147
	Mud		168
	Mixed		189
	Mud		210
	"		231
Information upon completion of well:	"		252
(1) Diameter <u>2</u> inches.	"		273
(2) Total Depth <u>334'</u> feet.	"		294
(3) Water Level <u>14 1/2'</u> feet below top of ground.	Sand 19' Good		315
(4) Cased to _____, Size _____			334
(5) Screen: Size <u>.08</u> , Length <u>6'</u>			
(6) Were any formations sealed against pollution? _____ yes, _____ no.			
If YES depth of formation _____			
Why _____			
Drillers Remarks: _____			

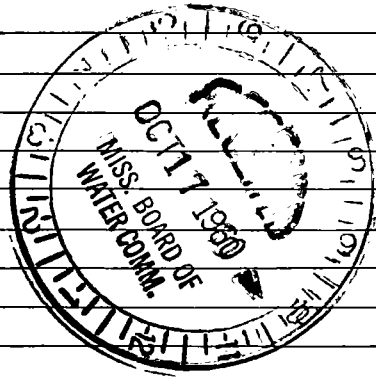

(Use Back Side)

Well No.

