

JACKSON

MISSISSIPPI BOARD OF WATER COMMISSIONERS

N 12 1/2 27

WATER WELL DRILLERS LOG

Date: 19-13-60 Oct. 13, 1960, Driller: L. R. Garland County Jackson  
45 (Name)

(1) Owner of Land: Mr. Sabage  
(Name)  
Ocean Springs  
(Address)  
(2) Location: SE 1/4, NW 1/4, Sec. 19 T25R 8W  
2 miles North, of O.S.  
(distance) (direction) (Nearest Town)  
(3) Topography: X  
(Hilly) (Flat) (Level)  
(4) Purpose of Well: Domestic  
(Domestic Irrigation  
Municipal, Industrial, Other)


Description & Color of Materials Sand, Clay, Red Clay, Shell, etc.	Thick- ness Feet	Depth Feet
21' Clay		21
21' Sand		42
21' Mud		63
21' Sand		84
"		105
11' Sand 10' Mud		126
8' " 13' "		147
Mud		168
"		189
"		210
"		231
12' Mud 5' Sand		252
16' " 5' "		273
18' Sand 3' Mud		294
21' Sand		315
12' Sand 6' Mud 3' Sand		336
12' Sand 9' Mud		357
Mud		378
"		399
4' " 17' Sand		420
Sand		441
20' Sand		462
10' Sand Good		472

Information upon completion of well:

(1) Diameter 2 inches.  
(2) Total Depth 472 feet.  
(3) Water Level 2' feet below top of ground.  
(4) Cased to \_\_\_\_\_, Size \_\_\_\_\_  
(5) Screen: Size .08, Length 10'  
(6) Were any formations sealed against pollution?  
\_\_\_\_\_ yes, \_\_\_\_\_ no.

If YES depth of formation \_\_\_\_\_  
Why \_\_\_\_\_

Drillers Remarks: \_\_\_\_\_  
\_\_\_\_\_  
\_\_\_\_\_

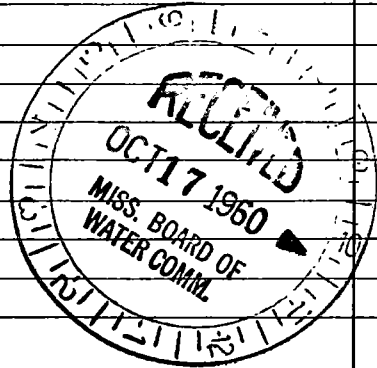

(Use Back Side)

Well No.

