

JACKSON

MISSISSIPPI BOARD OF WATER COMMISSIONERS

N 330

N 107

WATER WELL DRILLERS LOG

10-19-60

Date: Oct. 19, 1960, Driller: C. T. Switzer Well County Jackson

45

(Name)

(1) Owner of Land: Harney C. Zeigler
 Just north of Fort Bayou - Red Wing
 way 90 - East of Gulf Hills
 (Address)

(2) Location: $\frac{1}{4}$, NW, Sec. 19, T. 75, R. 8,
 Ocean
 $\frac{1}{2}$ miles N, of Spring,
 (distance) (direction) (Nearest Town)

(3) Topography: (Hilly) (Flat) (Level)

(4) Purpose of Well: domestic
 (Domestic Irrigation
 Municipal, Industrial, Other)

Description & Color of Materials Sand, Clay, Red Clay, Shell, etc.	Thick- ness Feet	Depth Feet
Clay	0	5
sand	5	40
Clay	40	55
fine sand	55	70
Clay	70	201
fine sand	201	216
Clay	216	280
sand	280	288
Clay	288	371
stratified	371	379
sand	379	384
Clay	384	456
sand - yard	456	472

Information upon completion of well:

(1) Diameter 2 inches.

(2) Total Depth 472 feet.

(3) Water Level 3' feet below top of ground.

(4) Cased to 472', Size 2"


(5) Screen: Size 8 ga, Length 10'

(6) Were any formations sealed against pollution?
 yes, no.

If YES depth of formation 10 feet

Why Health Dept. Requirement

Drillers Remarks:

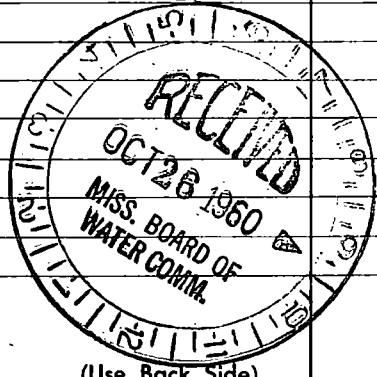

Well No.

