

N 108

WATER WELL DRILLERS LOG

~~10-26-60~~

10-26-60

Date: Oct 26 19 60, Driller: C. T. Switzer Well Co. County Jackson

5-5

(Name)

(1) Owner of Land: J. C. Beuchler
East North of Port Bayou - on
Highway 90 - East of Gulf Hills

(Address)

Description & Color of Materials
Sand, Clay, Red Clay, Shell, etc.

Thick-
ness
Feet

Depth
Feet

Clay
Sand

0 22
22 40

(2) Location: 1/4, 1/4, Sec. T R

1
2 miles N, of Ocean Springs
(distance) (direction) (Nearest Town)

(3) Topography:

(Hilly) (Flat) (Level)

(4) Purpose of Well: Domestic

(Domestic Irrigation
Municipal, Industrial, Other)

Information upon completion of well:

(1) Diameter 2 inches.

(2) Total Depth 40 feet.

(3) Water Level - 9' feet below top of ground.

(4) Cased to 40', Size 2"

(5) Screen: Size 25A, Length 6'
Clayton & mark


(6) Were any formations sealed against pollution?

 yes, no.

If YES depth of formation 10 feet

Why Health dept requirement

Drillers Remarks:

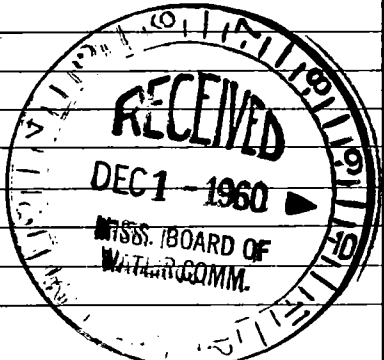

(Use Back Side)

Well No.

