

N 111

11-30-60

WATER WELL DRILLERS LOG

~~135~~

Date: Nov 30, 1960, Driller: L. L. Garland County Jackson
 65 (Name)

(1) Owner of Land: Mr. Collier
(Name)
A. Martin Community
(Address)

(2) Location: 1/4, 1/4, Sec. T. R
2 miles East, of D'Arbonneville
(distance) (direction) (Nearest Town)

(3) Topography:
(Hilly) (Flat) (Level)

(4) Purpose of Well: Domestic
(Domestic Irrigation Municipal, Industrial, Other)

Description & Color of Materials Sand, Clay, Red Clay, Shell, etc.	Thick- ness Feet	Depth Feet
21' Clay		
21' "		
7' Sand 14' Mud		
21' Mud		
21' "		
14' Sand 7' Mud		
21' Mud		
21' "		
21' "		
21' Sand		
10' " (Good)		220'

Information upon completion of well:

(1) Diameter 2 inches.

(2) Total Depth 220 feet.

(3) Water Level 7' feet below top of ground.

(4) Cased to , Size .


(5) Screen: Size .08, Length 6'.

(6) Were any formations sealed against pollution?
 yes, no.

If YES depth of formation

Why

Drillers Remarks:

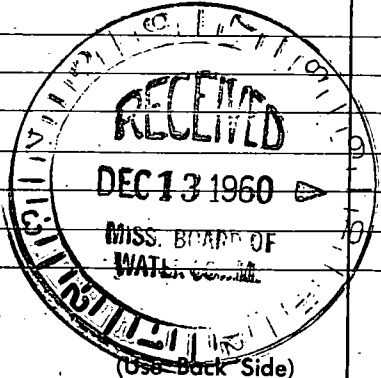

Well No.

