

JACKSON

N 112

5-61

WATER WELL DRILLERS LOG

Date: _____, 19____, Driller: L. L. Garland County Jackson
 (Name)

(1) Owner of Land: Dr. Ezell
 (Name)
Point Aux Chennes
 (Address)

(2) Location: _____ ¼, _____ ¼, Sec. _____ T. _____ R. _____
3 miles SW, of Fountain
 (distance) (direction) (Nearest Town)
Blair

(3) Topography: _____
 (Hilly) (Flat) (Level)

(4) Purpose of Well: Domestic
 (Domestic Irrigation
 Municipal, Industrial, Other)

Description & Color of Materials Sand, Clay, Red Clay, Shell, etc.	Thick- ness Feet	Depth Feet
21' Sand & Mud		
21' "		
42' Mixed (Mud & Sand)		
42' Sand		
63' Mixed " "		
42' Mud		
126' Mixed " "		
42' Mud		
126' Mixed " "		
21' Mud		
63' Mixed " "		
42' Mud		
273' Mixed " "		
42' Mud & Shale		
105' Mixed		
42' Fine Sand		
147' Mixed		
48' Sand (Good)		

Information upon completion of well:

(1) Diameter 2 inches.

(2) Total Depth 1389 feet.

(3) Water Level Flowed feet below top of ground.


(4) Cased to 1363, Size _____

(5) Screen: Size .08, Length 26'

(6) Were any formations sealed against pollution?
 _____ yes, _____ no.

If YES depth of formation _____
 Why _____

Drillers Remarks: _____

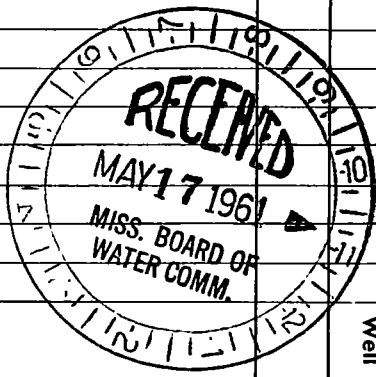

(Use Back Side)

Well No. _____

