

N 113
5-6t

WATER WELL DRILLERS LOG

Date: 55, 1955, Driller: L. L. Harland County Jackson
(Name)

(1) Owner of Land: Mr. Willie Hornflo Rd.
(Name)
(Address)

(2) Location: 1 miles North of St. Martin
(distance) (direction) (Nearest Town)

(3) Topography: Level
(Hilly) (Flat) (Level)

(4) Purpose of Well: Domestic
(Domestic Irrigation) (Municipal, Industrial, Other)

Description & Color of Materials Sand, Clay, Red Clay, Shell, etc.	Thick- ness Feet	Depth Feet
21' Clay		
84' Mixed		
21' Mud		
42' Mixed		
189' Mud		
63' Mud & Shale		
7' Mud 14' Sand (Good)		

Information upon completion of well:

(1) Diameter 2 inches.

(2) Total Depth 403 feet.

(3) Water Level 7 feet below top of ground.


(4) Cased to _____, Size _____

(5) Screen: Size .08, Length 10'

(6) Were any formations sealed against pollution?
_____ yes, _____ no.

If YES depth of formation _____
Why _____

Drillers Remarks: _____

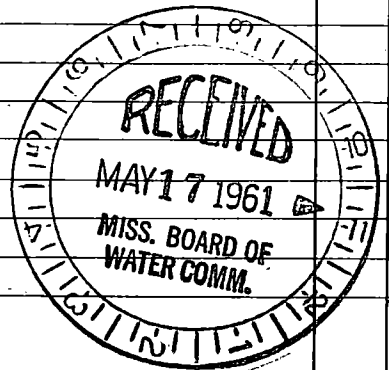

(Use Back Side)

Well No.

