

MISSISSIPPI BOARD OF WATER COMMISSIONERS

JACKSON

N 114 WATER WELL DRILLERS LOG

Date: 6-24-61, June 24, 1961, Driller: L.P. Harland County Jackson
 25 (Name)

(1) Owner of Land: Mr. White
 (Name)
Ocean Springs, Miss.
 (Address)
 (2) Location: 2 1/2 miles East of O.S.
 (distance) (direction) (Nearest Town)
 (3) Topography: (Flat)
 (Hilly) (Flat) (Level)
 (4) Purpose of Well: (Industrial)
 (Domestic Irrigation) (Municipal) (Industrial) (Other)

Description & Color of Materials Sand, Clay, Red Clay, Shell, etc.	Thick- ness Feet	Depth Feet
Surface Sand		21
Mixed		42
Sand & Mud Str.		63
Mud		84
"		105
Sand		126
Mud		147
Mixed		168
Sand		189
Mixed		210
Mud & Sand		231
" " Str.		252
Mud		273
"		294
"		315
"		336
"		357
"		378
" & Sand Str.		399
Sand & Mud		420
" " Str.		441
Fine Sand		462
Sand		483
"		504
Sand & Mud Str.		525
Hard Sand " "		546
Sand		567
17' Sand 4' Mud		588
Mud		609
" & Sand Str.		630
Mud		651
19' Mud 2' Sand		672

Information upon completion of well:


(1) Diameter 2 inches.
 (2) Total Depth 1323 feet.
 (3) Water Level Flowed feet below top of ground.
 (4) Cased to _____, Size _____
 (5) Screen: Size .08, Length 26
 (6) Were any formations sealed against pollution?

_____ yes, _____ no

If YES depth of formation _____

Why _____

Drillers Remarks: _____

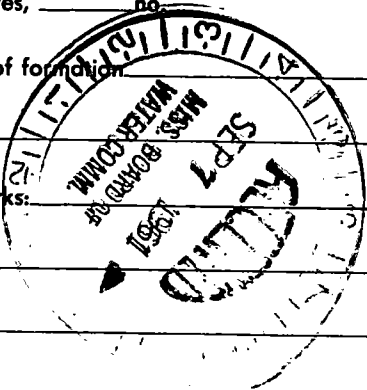

(Use Back Side)

Well No.

