

N 116

7-31-61

WATER WELL DRILLERS LOG

COLVILLE

Date: 7/31, 1961, Driller: Water Supply Co County JACKSON

Gulf Park Estate
(1) Owner of Land:
(Name)
RFD Ocean Springs Miss
(Address)

(2) Location: SW 1/4, NE 1/4, Sec. 2, T8S R8W
4 miles East of Ocean Springs
(distance) (direction) (Nearest Town)

(3) Topography:
(Hilly) (Flat) (Level) [checked]

(4) Purpose of Well:
(Domestic Irrigation)
(Municipal, Industrial) [checked] (Other)


Table with 4 columns: Description & Color of Materials, Thickness Feet, Depth Feet, and Depth Form. Rows include: 0 Sand:Clay, 10 Clay, 37 Clay, 75 Sand, 84 Clay, 153 Sand, 168 streaky, 202 streaks, 231 Clay, 262 Sand, 260 Clay, 375 Sand, 388 Clay, 405 Sand, 425 Clay, 457 Clay, 531 Sand, 577

Information upon completion of well:

- (1) Diameter 7 inches.
(2) Total Depth 577 feet.
(3) Water Level + 5'-6" feet below top of ground.
(4) Cased to, Size.
(5) Screen: Size 2", Length 20'.
(6) Were any formations sealed against pollution?
yes, no. [checked]

If YES depth of formation
Why

Drillers Remarks:
This well flows
12 gal per Min

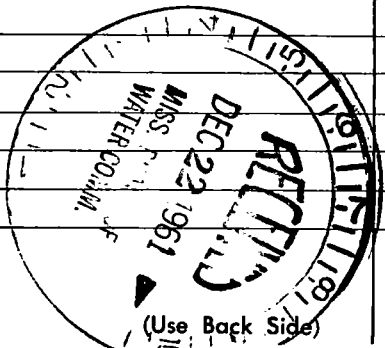

Well No. 116

