

JACKSON MISSISSIPPI BOARD OF WATER COMMISSIONERS

N 717

N

12-4-61

WATER WELL DRILLERS LOG


Date: Dec. 4, 1961, Driller: L. R. Garland County Jackson
 (Name)
 55

(1) Owner of Land	Description & Color of Materials Sand, Clay, Red Clay, Shell, etc.	Thick- ness Feet	Depth Feet
<u>J. C. Anderson</u> (Name) <u>St. Martin Community</u> (Address)	1 Clay		
	2 14' Sand 7' Mud		
	3 Mud		
	4 "		
(2) Location: <u>1/4</u> , <u>1/4</u> , Sec. <u>T R</u> <u>1</u> miles <u>EAST</u> of <u>School</u> (distance) (direction) (Nearest Town)	5 "		
	6 " & Sand Straps		
	7 13' Sand (Good)		
(3) Topography: _____ (Hilly) (Flat) (Level)			
(4) Purpose of Well: <u>Domestic</u> (Domestic Irrigation Municipal, Industrial, Other)			

Information upon completion of well:

- (1) Diameter 2 inches.
- (2) Total Depth 139 feet.
- (3) Water Level 6' feet below top of ground.
- (4) Cased to _____, Size _____.
- (5) Screen: Size .08, Length 10'.
- (6) Were any formations sealed against pollution?
 _____ yes, _____ no.

If YES depth of formation _____
 Why _____
 Drillers Remarks: _____

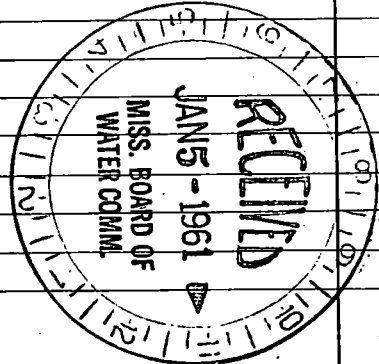

(Use Back Side)

Well No.

