

N 118  
12-6-61

WATER WELL DRILLERS LOG

Date: Dec 6, 1961, Driller: Colville County Jackson  
(Name)  
55

(1) Owner of Land: Charles Clepak  
(Name)  
Ocean Springs  
(Address)

(2) Location: 1/4, 1/4, Sec. T R  
1 miles North, of MEANS SPRING  
(distance) (direction) (Nearest Town)

(3) Topography: Hilly  
(Hilly) (Flat) (Level)

(4) Purpose of Well: Domestic  
(Domestic Irrigation  
Municipal, Industrial, Other)

Description & Color of Materials Sand, Clay, Red Clay, Shell, etc.	Thick- ness Feet	Depth Feet
<u>Yellow Sand</u>		<u>10</u>
<u>Clay &amp; Sand Strks</u>	<u>11</u>	<u>21</u>
<u>Gravel</u>	<u>21</u>	<u>42</u>
<u>Clay</u>	<u>5</u>	<u>47</u>
<u>Sand</u>	<u>3</u>	<u>50</u>
<u>Clay</u>	<u>324</u>	<u>374</u>
<u>Sand</u>	<u>4</u>	<u>378</u>
<u>Clay</u>	<u>63</u>	<u>441</u>
<u>Sand</u>	<u>47</u>	<u>488</u>
<u>Clay</u>		

Information upon completion of well:

(1) Diameter 2 inches.

(2) Total Depth 525 feet.

(3) Water Level 16' feet below top of ground.

(4) Cased to \_\_\_\_\_, Size \_\_\_\_\_


(5) Screen: Size 2", Length 30'

(6) Were any formations sealed against pollution?  
\_\_\_\_\_ yes,  no.

If YES depth of formation \_\_\_\_\_

Why \_\_\_\_\_

Drillers Remarks: \_\_\_\_\_

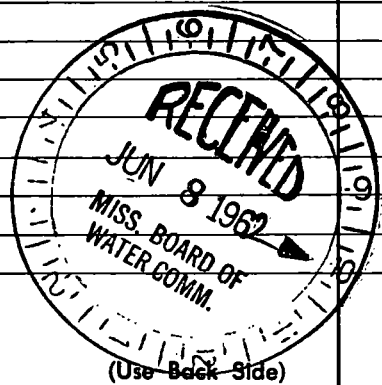

Well No. 98

