

# JACKSON MISSISSIPPI BOARD OF WATER COMMISSIONERS

N 119

N

12-17-61

## WATER WELL DRILLERS LOG

Date: Dec. 17, 1961, Driller: L. S. Farland County: Jackson  
(Name)

55

(1) Owner of Land: <u>Floyd Dobson</u> <small>(Name)</small> <u>St. Martin Community</u> <small>(Address)</small>		Description & Color of Materials Sand, Clay, Red Clay, Shell, etc.	Thick- ness Feet	Depth Feet
		1 14' Clay 7' Sand		
		2 12' Sand 9' Mud		
		3 Mud		
(2) Location: <u>1</u> $\frac{1}{4}$ miles <u>East</u> of <u>St. Martin School</u> <small>(distance) (direction) (Nearest Town)</small>		4 " 9' Sand & Shale		
		5 " " "		
		6 " " "		
(3) Topography: <u>(Level)</u> <small>(Hilly) (Flat) (Level)</small>		7 Mixed		
		8 " "		
(4) Purpose of Well: <u>Domestic</u> <small>(Domestic Irrigation) (Municipal, Industrial, Other)</small>		9 4' Mud 16' Sand 1' Mud		
		10 Mud & Shale		
		11 11' Shale 10' Sand		
		12 Mixed		
		13 Mud		
		14 " "		
		15 " "		
		16 " "		
		17 " "		
		18 " "		
		19 " "		
		20 14' Mud 7' Sand		
		21 7' Sand (Good)		


Information upon completion of well:

- (1) Diameter 2 inches.
- (2) Total Depth 427 feet.
- (3) Water Level Flowed feet below top of ground.
- (4) Cased to \_\_\_\_\_, Size \_\_\_\_\_.
- (5) Screen: Size .08, Length 10'.
- (6) Were any formations sealed against pollution?  
 \_\_\_\_\_ yes, \_\_\_\_\_ no.

If YES depth of formation \_\_\_\_\_

Why \_\_\_\_\_

Drillers Remarks: \_\_\_\_\_

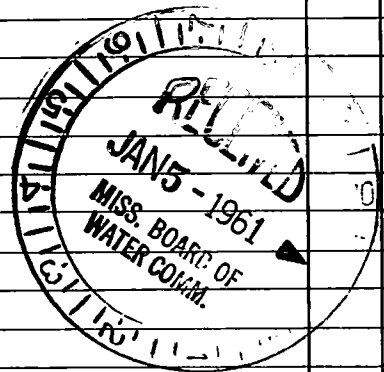

(Use Back Side)

Well No.

