

# JACKSON MISSISSIPPI BOARD OF WATER COMMISSIONERS

N 121

4-25-62

## WATER WELL DRILLERS LOG

Date: April 25, 1962, Driller: L. L. Harland County: Jackson  
(Name)

| (1) Owner of Land:  | Description & Color of Materials<br>Sand, Clay, Red Clay, Shell, etc. | Thick-<br>ness<br>Feet | Depth<br>Feet |
|---|---|------------------------|---------------|
| <u>Berryman</u><br><small>(Name)</small><br><u>Biloxi, Miss.</u><br><small>(Address)</small>  | 1 - 21' Clay  |                        |               |
| (2) Location: <u>1/4, 1/4, Sec 13 T. 7 R. 8</u><br><u>2</u> miles <u>NW</u> of <u>Ocean Springs</u><br><small>(distance) (direction) (Nearest Town)</small> | 2 - 21' mud & sand  |                        |               |
| (3) Topography: <u>Spring</u><br><small>(Hilly) (Flat) (Level)</small>  | 3 - " " "   |                        |               |
| (4) Purpose of Well: <u>Domestic</u><br><small>(Domestic Irrigation<br/>Municipal, Industrial, Other)</small>   | 4 - 18' mud 3' "  |                        |               |
|   | 5 - 21' mixed   |                        |               |
|   | 6 - " "   |                        |               |
|   | 7 - 21' mud   |                        |               |
|   | 8 - " "   |                        |               |
|   | 9 - " "   |                        |               |
|   | 10 - " mixed  |                        |               |
|   | 11 - sand o.k.  |                        |               |


Information upon completion of well:

- (1) Diameter 2 inches.
- (2) Total Depth 233 feet.
- (3) Water Level 33 feet below top of ground.
- (4) Cased to \_\_\_\_\_, Size \_\_\_\_\_.
- (5) Screen: Size 08, Length 10.
- (6) Were any formations sealed against pollution?  
 yes,  no.

If YES depth of formation \_\_\_\_\_.

Why \_\_\_\_\_.

Drillers Remarks: \_\_\_\_\_

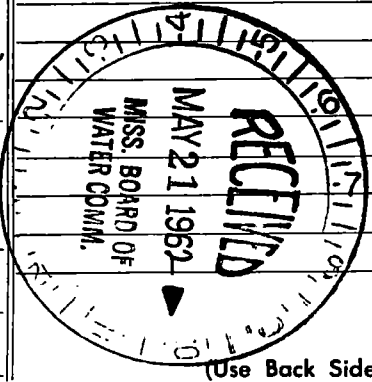

Well No.

Handwritten notes and scribbles at the top of the page, including a large 'X' on the left side and various illegible markings.

Handwritten notes on the right side of the page, including the number '10' and other illegible characters.

Handwritten notes at the bottom of the page, including the number '10' and other illegible characters.