


JACKSON MISSISSIPPI BOARD OF WATER COMMISSIONERS

N 122
5-4-62

WATER WELL DRILLERS LOG

Date: 5-4, 1962 Driller: C. T. SWITZER WELL CO. County: Jackson
 55 (Name)

(1) Owner of Land: <u>Miss Coast Research Lab.</u> <u>East Beach Ocean Springs</u> (Name) (Address)		Description & Color of Materials Sand, Clay, Red Clay, Shell, etc.	Thick- ness Feet	Depth Feet
(2) Location: <u>1/4</u> , <u>1/4</u> , Sec. <u>T. R.</u> <u>_____</u> miles <u>_____</u> of <u>_____</u> (distance) (direction) (Nearest Town)		Clay	30	34
(3) Topography: <input checked="" type="checkbox"/> (Hilly) <input type="checkbox"/> (Flat) <input type="checkbox"/> (Level)		Sand	34	43
(4) Purpose of Well: <u>Industrial</u> (Domestic Irrigation Municipal, Industrial, Other)		Clay	43	44
Information upon completion of well:		Sand & shls	44	64
(1) Diameter <u>4x3</u> inches.		Sand	64	119
(2) Total Depth <u>1205'</u> feet.		S. shls	119	125
(3) Water Level <u>30'</u> + feet below top of ground.		Sand	125	173
(4) Cased to <u>1205'</u> , Size <u>4x3"</u>		Clay	173	190
(5) Screen: Size <u>4x3"</u> , Length <u>40'</u>		Sand	190	198
(6) Were any formations sealed against pollution? <input checked="" type="checkbox"/> yes, <input type="checkbox"/> no.		Clay	198	206
If YES depth of formation		Clay	206	328
Why <u>None</u>		Clay, soft.	328	348
Drillers Remarks:		Clay & sand shls	348	368
		Clay	368	502
		Sand	502	579
		Clay	579	615
		Clay, sand shls	615	635
		Sand, fine	635	656
		Sand, fine	656	676
		Sand, fine	676	691
		Clay	691	696
		Sand, shls	696	719
		Clay	719	730
		Rock 3"	730	739
		Clay	739	759
		Sand shls	759	770
		Sand	770	779
		Sand shls	779	799
		Sand, fine	799	821
		Clay shls	821	841
		Clay	841	881
		Sand shls	881	902

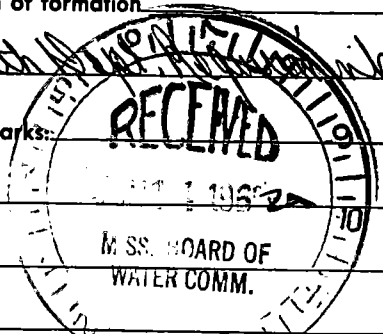

(Use Back Side)

Well No.

Retain this copy for your office files.

