

JACKSON MISSISSIPPI BOARD OF WATER COMMISSIONERS

N 123

5-28-62

WATER WELL DRILLERS LOG

Date: May 28, 1962, Driller: Colville County Jackson
 55 (Name)

(1) Owner of Land:	Description & Color of Materials Sand, Clay, Red Clay, Shell, etc.	Thick- ness Feet	Depth Feet
<u>Mrs. A.T. Rainey</u> (Name) <u>Ocean Springs, Miss.</u> (Address)	<u>CLAY</u> <u>CLAY w/sand STRKS</u> <u>2 SAND</u>	<u>21</u> <u>329</u> <u>38</u>	<u>21</u> <u>350</u> <u>388</u>
(2) Location: <u>NW 1/4, NE 1/4, Sec. 24 T. 7 R. 8,</u> <u>6 miles East</u> of <u>Ocean Springs</u> (distance) (direction) (Nearest Town)			
(3) Topography: <u>Flat</u> (Hilly) (Flat) (Level)			
(4) Purpose of Well: <u>Domestic</u> (Domestic Irrigation Municipal, Industrial, Other)			


Information upon completion of well:

- (1) Diameter 1 1/4 inches.
- (2) Total Depth 388 feet.
- (3) Water Level 19 feet below top of ground.
- (4) Cased to 378, Size 1 1/4.
- (5) Screen: Size 80 mesh, Length 10'.
- (6) Were any formations sealed against pollution?
 yes, no.

If YES depth of formation _____

Why _____

Drillers Remarks: _____

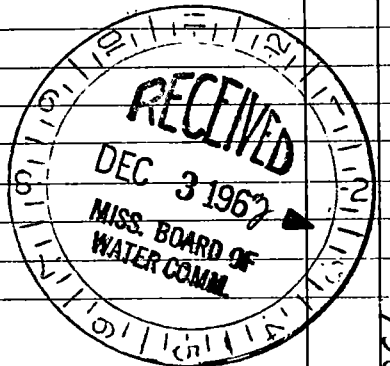

(Use Back Side)

Well No
135

