

# JACKSON MISSISSIPPI BOARD OF WATER COMMISSIONERS

N 124

6-3-62

## WATER WELL DRILLERS LOG

Date: June 3, 1962, Driller: L. S. Garland County: Jackson  
 (Name)

(1) Owner of Land: M. R. Razon  
Halstead Road  
 (Address)

(2) Location: 1/4, 1/4, Sec. 28 T7 R8W  
2 miles SE of Orl.  
 (distance) (direction) (Nearest Town)

(3) Topography: Flat  
 (Hilly) (Flat) (Level)

(4) Purpose of Well: Domestic  
 (Domestic Irrigation Municipal, Industrial, Other)

	Description & Color of Materials Sand, Clay, Red Clay, Shell, etc.	Thick- ness Feet	Depth Feet
1	Sand & Mud		
2	Mud & Sand Strbs		
3	Sand		
4	"		
5	" & Mud Strbs.		
6	14' Sand 7' Mud		
7	Mixed		
8	"		
9	Mud		
10	"		
11	"		
12	"		
13	"		
14	" & S. Strbs.		
15	" "		
16	" "		
17	" & Shale		
18	" "		
19	" "		
20	" "		
21	" "		
22	Mud		
23	"		
24	" & sand Strbs		
25	11' Mud 10' Sand		
26	21' Sand		
	Good		

Information upon completion of well:

(1) Diameter: 2 inches.

(2) Total Depth: 546 feet.

(3) Water Level: 2' feet below top of ground.

(4) Cased to \_\_\_\_\_, Size \_\_\_\_\_


(5) Screen: Size .08, Length 10'

(6) Were any formations sealed against pollution?  
 \_\_\_\_\_ yes, \_\_\_\_\_ no.

If YES depth of formation \_\_\_\_\_

Why \_\_\_\_\_

Drillers Remarks: \_\_\_\_\_

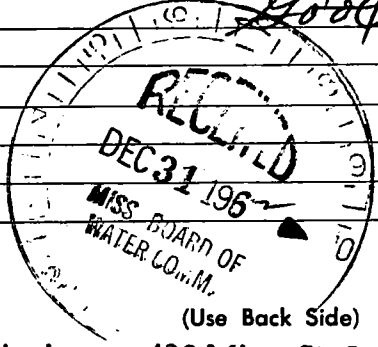

Well No.

