

JACKSON MISSISSIPPI BOARD OF WATER COMMISSIONERS

N 125
6-5-62

WATER WELL DRILLERS LOG

Date: June 5, 1962, Driller: L. L. Garland, County: Jackson
55 (Name)

(1) Owner of Land: Duck Gunn
(Name)
Halstead Road
(Address)

(2) Location: 38 T 7 R 8 W 4
2 miles EAST of O.S.
(distance) (direction) (Nearest Town)

(3) Topography: (Hilly) (Flat) (Level)

(4) Purpose of Well: Domestic
(Domestic Irrigation, Municipal, Industrial, Other)

	Description & Color of Materials Sand, Clay, Red Clay, Shell, etc.	Thick- ness Feet	Depth Feet
1	Sand		
2	10' Sand 11' Mud		
3	18' Sand 3' "		
4	Mud		
5	Sand & Mud Strbs		
6	" "	"	"
7	" "	"	"
8	18' Sand 3' Mud		
9	Mud		
10	"		
11	"		
12	Mud & Shale		
13	"		
14	" & Rock		
15	18' Mud 3' Sand		
16	Mud & Sand Strbs		
17	" "	"	"
18	Mud		
19	" & Shale		
20	" "	"	"
21	" "	"	"
22	" "	"	"
23	" "	"	"
24	Sand		
25	10' Mud 11' Sand		
26	18' Sand		

Information upon completion of well:

(1) Diameter 2 inches.

(2) Total Depth 542 feet.

(3) Water Level 15' feet below top of ground.

(4) Cased to _____, Size _____


(5) Screen: Size .08, Length 10'

(6) Were any formations sealed against pollution?
_____ yes, _____ no.

If YES depth of formation _____

Why _____

Drillers Remarks: _____

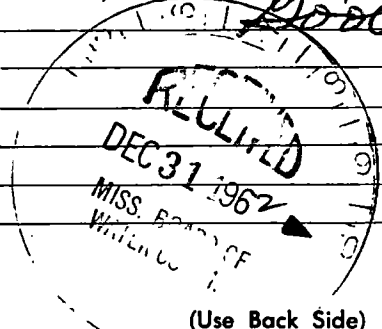

(Use Back Side)

Well No.

