

JACKSON MISSISSIPPI BOARD OF WATER COMMISSIONERS

N 126
6-11-62

WATER WELL DRILLERS LOG

Date: June 11, 1962, Driller: L. L. Harland County: Jackson
(Name)

(1) Owner of Land	Description & Color of Materials Sand, Clay, Red Clay, Shell, etc.	Thick- ness Feet	Depth Feet
<u>Mack Williams</u> (Name)	<u>1-2 Mud</u>		
<u>D. I. D'Arville</u> (Address)	<u>3 Mud & Sand Strips</u>		
(2) Location: <u>1/4</u> , <u>1/4</u> , Sec. <u>16 T. 7 R. 9</u>	<u>4 Sand</u>		
<u>3</u> miles <u>West</u> of <u>O. S.</u>	<u>5 18' Mud 3' Sand</u>		
(distance) (direction) (Nearest Town)	<u>6. Mud</u>		
(3) Topography: <u>(Flat)</u>	<u>7 " & Sand Strips</u>		
(Hilly) (Flat) (Level)	<u>8-9-10-11- Mud</u>		
(4) Purpose of Well: <u>Domestic</u>	<u>12-13- Mixed</u>		
(Domestic Irrigation Municipal, Industrial, Other)	<u>14-15- Mud</u>		
	<u>16 Shale</u>		
	<u>17- " & Mud</u>		
	<u>18- " 19- Mud</u>		
	<u>20-21-22-23- Mud</u>		
	<u>24 Hard Shale</u>		
	<u>25- Shale & Mud</u>		
	<u>26- " Hard</u>		
	<u>27 Mud & Sand Str.</u>		
	<u>28-29 " & Shale</u>		
	<u>30- Mixed</u>		
	<u>31- Sand & Shale</u>		
	<u>32- Mud</u>		
	<u>33- Shale</u>		
	<u>34- Shale & Mud</u>		
	<u>35- Mud</u>		
	<u>36- Mixed</u>		
	<u>37 14' Sand Fine 7' Sand</u>		
	<u>38- Mixed</u>		
	<u>39- Sand</u>		
	<u>40- 7' Sand C. F.</u>		


Information upon completion of well:

- (1) Diameter 2 inches.
- (2) Total Depth 826 feet.
- (3) Water Level Flowed feet below top of ground.
- (4) Cased to _____, Size _____.
- (5) Screen: Size .08, Length 26'
- (6) Were any formations sealed against pollution?
_____ yes, _____ no.

If YES depth of formation _____

Why _____

Drillers Remarks: _____

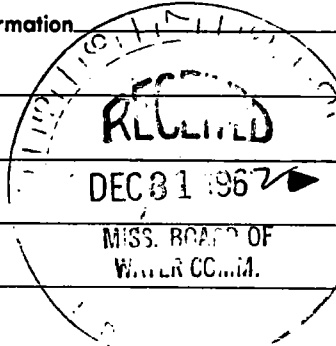

(Use Back Side)

