

JACKSON MISSISSIPPI BOARD OF WATER COMMISSIONERS

N 132

7-2-62

WATER WELL DRILLERS LOG

Date: July 2, 1962 Driller: L. L. Horland County: Jackson

(Name)

(1) Owner of Land:	Description & Color of Materials Sand, Clay, Red Clay, Shell, etc.	Thick- ness Feet	Depth Feet
<u>Henry King</u> (Name) <u>Hornflo Ave.</u> (Address)	1- Clay		
	2- Mud		
(2) Location: $\frac{1}{4}$, $\frac{1}{4}$, Sec. <u>16 T. 7 R. 9</u>	3- 10' Mud 11' Sand		
<u>3</u> miles <u>N.W.</u> of <u>O.S.</u> (Distance) (direction) (Nearest Town)	4- 14' Sand 7' Mud		
(3) Topography: <u>Dom.</u> (Hilly) (Flat) (Level)	5- Mud		
(4) Purpose of Well: <u>Dom.</u> (Domestic Irrigation Municipal, Industrial, Other)	6- 10' Sand 11' Mud		
	7- Mix		
	8- 9- 10' - 11' - Mix		
	12- 13- 14- Mud		
	15- 16- 17- 18- Mud Shale		
	19- 20- 21- Mix		
	22- 23- 24- 25- Shale		
	26- 27- 28- 29- Mud		
	30- Shale & Sand Sh		
	31- 32- 33- 34- Shale		
	35- 18' Shale 3' Sand		
	36- Mix		
	37- 18' Shale 3' Sand		
	38- Sand		
	39- " O.T.		

Information upon completion of well:

(1) Diameter 2 inches.

(2) Total Depth 819 feet.

(3) Water Level Flowed feet below top of ground.

(4) Cased to _____, Size _____.


(5) Screen: Size .08, Length 16'.

(6) Were any formations sealed against pollution?
 yes, no.

If YES depth of formation _____

Why _____

Drillers Remarks: _____

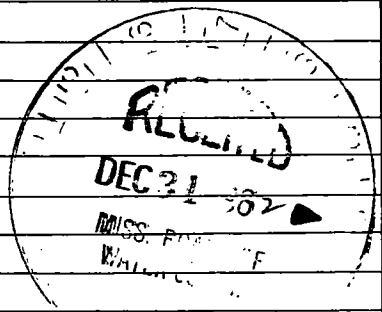

(Use Back Side)

Well No.

