

JACKSON MISSISSIPPI BOARD OF WATER COMMISSIONERS

N 133
7-11-62

WATER WELL DRILLERS LOG

Date: July 11, 1962, Driller: M & B Drilling Co. County Jackson
45 (Name)

(1) Owner of Land: Clifton L. Hustli
(Name)
R. Route Biloxi, Miss
(Address)

(2) Location: NE 1/4, NW 1/4, Sec. 3 D582
6 miles N of Biloxi
(distance) (direction) (Nearest Town)

(3) Topography: Flat
(Hilly) (Flat) (Level)

(4) Purpose of Well: Domestic
(Domestic Irrigation
Municipal, Industrial, Other)

Description & Color of Materials Sand, Clay, Red Clay, Shell, etc.	Thick- ness Feet	Depth Feet
Clay	15	15
White Sand	20	35
White Clay	15	50
White Sand	30	80
Blue Clay	5	85
Grey Sand	9	94
Blue Clay	134	228
Grey Sand	6	234


Information upon completion of well:

- (1) Diameter 2 inches.
- (2) Total Depth 233 feet.
- (3) Water Level 50 feet below top of ground.
- (4) Cased to 228, Size 2"
- (5) Screen: Size 2" X 8 1/2" Length 5 FT.
- (6) Were any formations sealed against pollution?
_____ yes, _____ no.

If YES depth of formation _____

Why _____

Drillers Remarks: _____

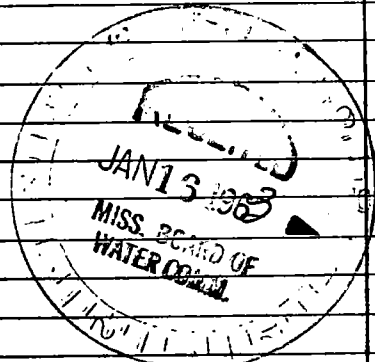

(Use Back Side)

Well No.

June 11, 1912

Dear Mr. [Name]

I have received your letter of the 10th and am glad to hear that you are interested in the [Project Name]. I have been thinking about this for some time and believe it is a very important one. I will be glad to discuss it with you further.

Sincerely,
[Name]

Yours truly,
[Name]

[Signature]

[Address]

Very truly yours,
[Name]

(10) Each day tomorrow you will see...