

JACKSON

WATER COMMISSIONERS

N 136

WATER WELL DRILLERS LOG

7-14-62

Date July 14, 1962 Driller: L. S. Herland County Jackson

6-15 (Name)

(1) Owner of Land: E. Roberts  
 (Name)  
Pass Road  
 (Address)

(2) Location: 10 T 7 R 9  
7 miles East of Duloxi  
 (distance) (direction) (Nearest Town)

(3) Topography: Level  
 (Hilly) (Flat) (Level)

(4) Purpose of Well: Dom.  
 (Domestic Irrigation) (Municipal, Industrial, Other)

Information upon completion of well:

(1) Diameter 2 inches.

(2) Total Depth 690 feet.

(3) Water Level 15' feet below top of ground.

(4) Cased to \_\_\_\_\_, Size \_\_\_\_\_

(5) Screen: Size 108, Length 20'


(6) Were any formations sealed against pollution?  
 \_\_\_\_\_ yes, \_\_\_\_\_ no.

If YES depth of formation \_\_\_\_\_

Why \_\_\_\_\_

Drillers Remarks: \_\_\_\_\_

Description & Color of Materials Sand, Clay, Red Clay, Shell, etc.	Thick- ness Feet	Depth Feet
1 Sand		
2. 19' Sand 2' Sand		
3 10' Mud 11' Sand		
4 Mix.		
5 "		
6 Mud		
7 "		
8 " & Sand Strips		
9-10-11-12-13 Mud		
14-15 Mud & Shale		
16-17 Mixed		
18-19 "		
20 Sand & Mud Strips		
21-22 Shale		
23-24 Mix.		
25 Shale		
26-27 Mud & Shale		
28 17' Shale 4' Rock		
29 Mix.		
30 14' Sand 7' Shale		
31 Sand Strips		
32 Sand		
33 18' Sand O.H.		

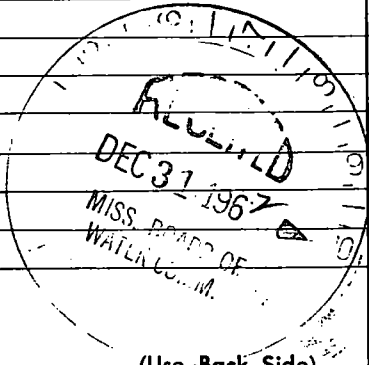

Well No.

