

JACKSON MISSISSIPPI BOARD OF WATER COMMISSIONERS

N 139
8-13-62

WATER WELL DRILLERS LOG

Date: Aug 13, 1962, Driller: M & B Drilling Co. County Jackson
450 (Name)

(1) Owner of Land: Nora Stanley
(Name)
A. B. Bilori, Miss.
(Address)

(2) Location: N 1/4, SW 1/4, Sec 7 T5R24
_____ miles _____ of _____
(distance) (direction) (Nearest Town)

(3) Topography: Flat
(Hilly) (Flat) (Level)

(4) Purpose of Well: Domestic
(Domestic Irrigation
Municipal, Industrial, Other)

Description & Color of Materials Sand, Clay, Red Clay, Shell, etc.	Thick- ness Feet	Depth Feet
Clay	18	14
White Sand	9	23
Black Clay	15	38
White Sand	4	42
Blue Clay	120	162
Sand (Fine)	12	174
Blue Clay	92	268
Fine Sand	22	290
Hard Blue/ellow Clay	20	310
Coarse Grey Sand	30	390

Information upon completion of well:

(1) Diameter 2 inches.

(2) Total Depth 390 feet.

(3) Water Level 3 feet below top of ground.

(4) Cased to 370, Size 2"


(5) Screen: Size 2" X 1/8" Length 10 FT.

(6) Were any formations sealed against pollution?
_____ yes, _____ no.

If YES depth of formation _____

Why _____

Drillers Remarks: _____

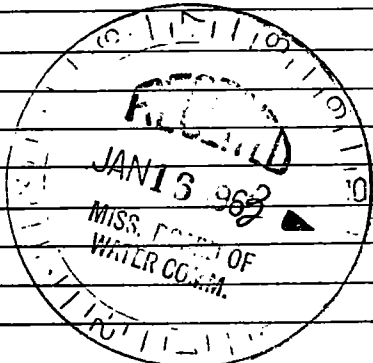

(Use Back Side)

Well No.

