

JACKSON MISSISSIPPI BOARD OF WATER COMMISSIONERS

N 140

8-14-62

WATER WELL DRILLERS LOG

Date: Aug 14, 1962, Driller: L. L. Farland County Jackson
(Name)

(1) Owner of Land:	Description & Color of Materials Sand, Clay, Red Clay, Shell, etc.	Thick- ness Feet	Depth Feet
<u>Mr. Skinner</u> <small>(Name)</small>	1 - Clay		
<u>Ocean Springs</u> <small>(Address)</small>	2 - Mixed		
(2) Location: <u>26 T. 7 S.</u>	3 - 14' Sand 7' Mud		
<u>3 miles East</u> of <u>O.S.</u>	4 - Mud		
<small>(distance) (direction) (Nearest Town)</small>	5 - "		
(3) Topography: <u>Dom</u>	6 - 15' Mud 6' Sand		
<small>(Hilly) (Flat) (Level)</small>	7 - 16' Sand 5' Mud		
(4) Purpose of Well: <u>Dom</u>	8 - Mud		
<small>(Domestic Irrigation Municipal, Industrial, Other)</small>	9 - Mud		
	10 - Mud		
	11 - "		
	12 - "		
	13 - "		
	14 - Mud & Sand Strata		
	15 - " " "		
	16 - " " "		
	17 - " " "		
	18 - 18' Mud 3' Sand		
	19 - Mud & Shale		
	20 - " " "		
	21 - " " "		
	22 - 18' Mud 3' Sand		
	23 - Sand		
	24 - 20' Sand O.S.		


Information upon completion of well:

- (1) Diameter 2 inches.
- (2) Total Depth 503 feet.
- (3) Water Level 7' feet below top of ground.
- (4) Cased to _____, Size _____.
- (5) Screen: Size .08, Length 10'.
- (6) Were any formations sealed against pollution?
 _____ yes, _____ no.

If YES depth of formation _____

Why _____

Drillers Remarks: _____

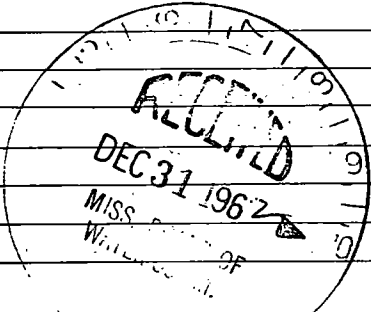

(Use Back Side)

Well No.

