

# JACKSON MISSISSIPPI BOARD OF WATER COMMISSIONERS

N 141

8-14-62

## WATER WELL DRILLERS LOG

Date: August 14, 1962, Driller: Mo B Drilling Co. County Jackson  
 45  
 (Name)

(1) Owner of Land: James Woodard  
 (Name)  
Fort Bayou Rd., Ocean Springs  
 (Address)

(2) Location: NE 1/4, NW 1/4, Sec. 18 T25N E2W  
1 miles North, of Ocean Springs  
 (distance) (direction) (Nearest Town)

(3) Topography: Flat  
 (Hilly) (Flat) (Level)

(4) Purpose of Well: Domestic  
 (Domestic Irrigation  
 Municipal, Industrial, Other)

Description & Color of Materials Sand, Clay, Red Clay, Shell, etc.	Thick- ness Feet	Depth Feet
Clay	14	14
White Sand	24	38
White Clay	36	74
Black Clay	6	80
White Sand	14	94
Blue Clay	1	95
Grey Sand	10	105

Information upon completion of well:

(1) Diameter 2 inches.

(2) Total Depth 103 feet.

(3) Water Level 14 feet below top of ground.

(4) Cased to 98 FT., Size 2"


(5) Screen: Size 2" x 8/16", Length 5 FT.

(6) Were any formations sealed against pollution?  
 \_\_\_\_\_ yes, \_\_\_\_\_ no.

If YES depth of formation \_\_\_\_\_

Why \_\_\_\_\_

Drillers Remarks: \_\_\_\_\_

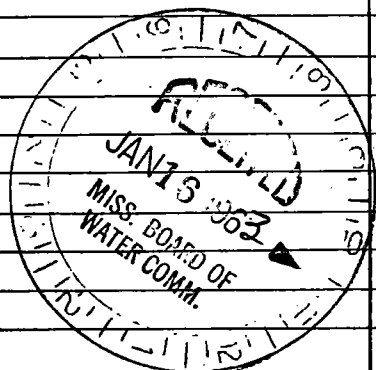

(Use Back Side)

Well No.

W. J. ...

...  
...  
...

...

100

11

...

...

...