

# JACKSON MISSISSIPPI BOARD OF WATER COMMISSIONERS

N 142

8-21-62

## WATER WELL DRILLERS LOG

Date: Aug. 21, 1962, Driller: M+B Drilling Co. County Jackson

45

(Name)

(1) Owner of Land: Albert Pickard  
 Building Contractor

(Name)

(Address)

(2) Location: NE 1/4, SE 1/4, Sec. 1 S5R5E

2 miles SW of Fontaineblau  
 (distance) (direction) (Nearest Town)

(3) Topography: Flat  
 (Hilly) (Flat) (Level)

(4) Purpose of Well: Domestic  
 (Domestic Irrigation  
 Municipal, Industrial, Other)

Description & Color of Materials Sand, Clay, Red Clay, Shell, etc.	Thick- ness Feet	Depth Feet
Clay	16	16
White Sand	32	48
Blue Clay	82	130
Sand & Clay breaks	50	180
Blue Clay	32	212
Grey Sand	23	235

### Information upon completion of well:

(1) Diameter 2 inches.

(2) Total Depth 233 feet.

(3) Water Level 7 feet below top of ground.

(4) Cased to 223 FT Size 2"


(5) Screen: Size 2" X 3/8" slot, Length 10 FT.

(6) Were any formations sealed against pollution?  
 \_\_\_\_\_ yes, \_\_\_\_\_ no.

If YES depth of formation \_\_\_\_\_

Why \_\_\_\_\_

Drillers Remarks: \_\_\_\_\_

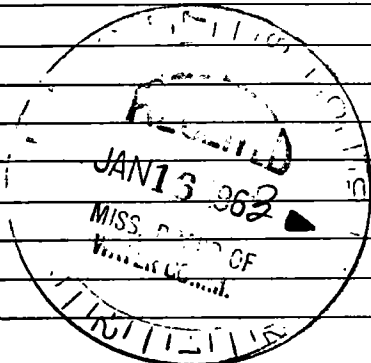

(Use Back Side)

Well No.

