

JACKSON MISSISSIPPI BOARD OF WATER COMMISSIONERS

N 144
9-22-62

WATER WELL DRILLERS LOG

Date: Sept. 22, 1962, Driller: M & B Drilling Co. County: Jackson
(Name)

(1) Owner of Land: Henry Honds
Rural Route, Ocean Springs
(Name)
(Address)

(2) Location: SW 1/4, SW 1/4, Sec. 7 T5R1E1
2 miles N, of Ocean Springs
(distance) (direction) (Nearest Town)

(3) Topography: Flat
(Hilly) (Flat) (Level)

(4) Purpose of Well: Domestic
(Domestic Irrigation)
Municipal, Industrial, Other)

Description & Color of Materials Sand, Clay, Red Clay, Shell, etc.	Thick- ness Feet	Depth Feet
Clay	10	10
White Sand	20	30
White Clay	20	50
White Sand	47	97
Blue Clay	23	120
Fine Sand	27	147
Blue Clay	53	200
Grey Sand	10	210
Blue Clay	125	335
Coarse Grey Sand	20	355

Information upon completion of well:

(1) Diameter 2 inches.

(2) Total Depth 355 feet.

(3) Water Level 11 feet below top of ground.

(4) Cased to 349, Size 2"


(5) Screen: Size 2" XPS/ft, Length 6 FT.

(6) Were any formations sealed against pollution?
 _____ yes, _____ no.

If YES depth of formation _____

Why _____

Drillers Remarks: _____

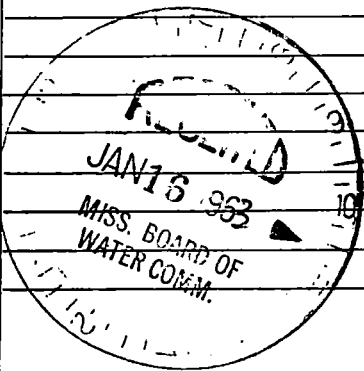

(Use Back Side)

Well No.

