

# JACKSON MISSISSIPPI BOARD OF WATER COMMISSIONERS

N 145  
9-24-62

## WATER WELL DRILLERS LOG


Date: Sept 24, 1962, Driller: R. P. Garland County Jackson  
(Name)

(1) Owner of Land:	Description & Color of Materials Sand, Clay, Red Clay, Shell, etc.	Thick- ness Feet	Depth Feet
<u>Amy Burbett</u> <small>(Name)</small> <u>O. S. Miss.</u> <small>(Address)</small>	1 18' Mud 3' Sand		
(2) Location: $\frac{1}{4}$ , $\frac{1}{4}$ , Sec <u>13</u> T <u>758</u> N <u>2</u> miles <u>North</u> of <u>O. S.</u> <small>(distance) (direction) (Nearest Town)</small>	2 Sand		
(3) Topography: <u>Domestic</u> <small>(Hilly) (Flat) (Level)</small>	3 Mud		
(4) Purpose of Well: <u>Domestic</u> <small>(Domestic Irrigation Municipal, Industrial, Other)</small>	4 10' Sand 11' Mud		
	5 Sand Str. & Mud		
	6 " "		
	7 Mud		
	8 " "		
	9 " "		
	10 " "		
	11 " "		
	12 " & Sand Strbs.		
	13 " "		
	14 18' Mud 3' Sand		
	15 Mud		
	16 " "		
	17 Mixed		
	18 Hard Shale		
	19 Shale & Sand Strbs		
	20 Sand		
	21 16' Sand (Good)		

Information upon completion of well:

- (1) Diameter 2 inches.
- (2) Total Depth 436 feet.
- (3) Water Level 4 feet below top of ground.
- (4) Cased to \_\_\_\_\_, Size \_\_\_\_\_
- (5) Screen: Size 08, Length 16'
- (6) Were any formations sealed against pollution?  
 yes,  no.

If YES depth of formation \_\_\_\_\_  
 Why \_\_\_\_\_  
 Drillers Remarks: \_\_\_\_\_

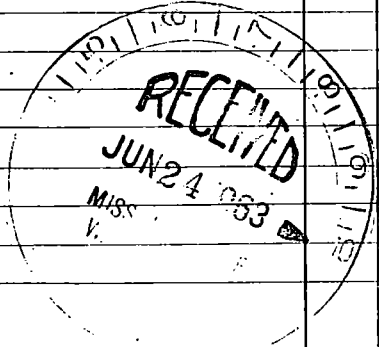

(Use Back Side)

Well No.

