

N 147

9-25-62

WATER WELL DRILLERS LOG

Date: Sept. 25, 1962, Driller: M & B Drilling Co. County: Jackson
53
(Name)

(1) Owner of Land: Carl Miller
Rural Route, Biloxi, Miss.
(Address)

(2) Location: NE 1/4, 1/4 Sec. 15 T5S R10E
3 miles NE of Biloxi
(distance) (direction) (Nearest Town)

(3) Topography: Flat
(Hilly) (Flat) (Level)

(4) Purpose of Well: Domestic
(Domestic Irrigation Municipal, Industrial, Other)

Description & Color of Materials Sand, Clay, Red Clay, Shell, etc.	Thickness Feet	Depth Feet
<u>Black Clay - White Clay</u>	<u>25</u>	<u>25</u>
<u>Blue Clay</u>	<u>122</u>	<u>147</u>
<u>Fine Grey Sand</u>	<u>6</u>	<u>153</u>
<u>Blue Clay</u>	<u>25</u>	<u>178</u>
<u>Grey Sand</u>	<u>8</u>	<u>186</u>

Information upon completion of well:

(1) Diameter: 2 inches.

(2) Total Depth: 184 feet.

(3) Water Level: 1 feet below top of ground.

(4) Cased to: 179, Size: 2"


(5) Screen: Size 2" X 8 slot, Length 5 FT.

(6) Were any formations sealed against pollution?
_____ yes, _____ no.

If YES depth of formation _____

Why _____

Drillers Remarks: _____

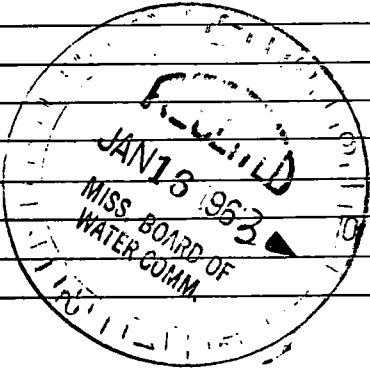

(Use Back Side)

Well No.

March 1952

W. H. R. ...

...

20.1.1952

...

...

