

JACKSON MISSISSIPPI BOARD OF WATER COMMISSIONERS

N 148

10-16-62

WATER WELL DRILLERS LOG

Date: Oct. 16, 1962 Driller: L. L. Garland County Jackson
(Name)

(1) Owner of Land:	Description & Color of Materials Sand, Clay, Red Clay, Shell, etc.	Thick- ness Feet	Depth Feet
<u>Vernon Krohn</u> <small>(Name)</small>	1 <u>Clay</u>		
<u>Rt. 1 O.S. Miss.</u> <small>(Address)</small>	2 <u>mixed</u>		
(2) Location: <u>1/4, 1/4, Sec. 18 T28R8N</u>	3 <u>"</u>		
<u>_____</u> miles of <u>_____</u> <small>(distance) (direction) (Nearest Town)</small>	4 <u>"</u>		
(3) Topography: <u>_____</u> <small>(Hilly) (Flat) (Level)</small>	5 <u>"</u>		
(4) Purpose of Well: <u>Domestic</u> <small>(Domestic Irrigation Municipal, Industrial, Other)</small>	6 <u>" & Sand Strbs.</u>		
	7 <u>mixed</u>		
	8 <u>mixed</u>		
	9 <u>mixed</u>		
	10 <u>mixed</u>		
	11 <u>mixed</u>		
	12 <u>16' mud 5' sand</u>		
	13 <u>9' sand</u>		


Information upon completion of well:

- (1) Diameter _____ inches.
- (2) Total Depth 271 feet.
- (3) Water Level 8 1/2 feet below top of ground.
- (4) Cased to _____, Size _____.
- (5) Screen: Size .08, Length 10'.
- (6) Were any formations sealed against pollution?
 yes, no.

If YES depth of formation _____

Why _____

Drillers Remarks: _____

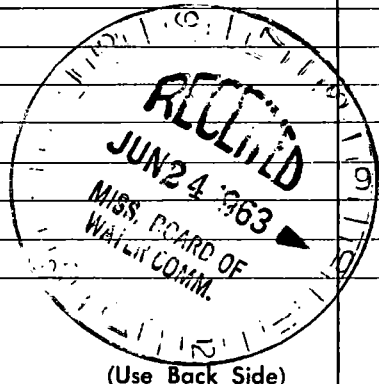

Well No. _____

