

JACKSON MISSISSIPPI BOARD OF WATER COMMISSIONERS

N 149

10-25-62 WATER WELL DRILLERS LOG


Date: Oct. 25, 1962 Driller: L. L. Garland County: Jackson
 55 (Name)

| | Description & Color of Materials Sand, Clay, Red Clay, Shell, etc. | Thick- ness Feet | Depth Feet |
|---|---|------------------------|---------------|
| (1) Owner of Land: <u>Ernest Zettell</u> (Name) <u>O. S. Miss.</u> (Address) | 1 6' Clay 15' Mix. | | |
| (2) Location: <u>1/4, 1/4, Sec 27 T 75 R 8 W</u> <u>3</u> miles <u>East</u> of <u>O. S.</u> (distance) (direction) (Nearest Town) | 2 10' S. 11' Mud | | |
| (3) Topography: (Hilly) (Flat) <input checked="" type="radio"/> (Level) | 3 Sand | | |
| (4) Purpose of Well: <u>Dam</u> (Domestic Irrigation Municipal, Industrial, Other) | 4 14' M. 7' S. | | |
| | 5 Mix. | | |
| | 6 Sand | | |
| | 7 11' Mud 10' S. | | |
| | 8 Sand | | |
| | 9 Mud | | |
| | 10 " | | |
| | 11 16' M. 5' Sand | | |
| | 12 Mud | | |
| | 13 Mix | | |
| | 14 Mud | | |
| | 15 " | | |
| | 16 " 8' S. | | |
| | 17 " 7' Shale | | |
| | 18 " | | |
| | 19 " | | |
| | 20 " | | |
| | 21 " | | |
| | 22 Fine Sand | | |
| | 23 Mud | | |
| | 24 Sand | | |
| | 25 1st Sand | | |

Information upon completion of well:

- (1) Diameter 2 inches.
- (2) Total Depth 514 feet.
- (3) Water level 4 feet below top of ground.
- (4) Cased to _____, Size _____
- (5) Screen: Size 08, Length 10'
- (6) Were any formations sealed against pollution?
 _____ yes, _____ no.

If YES depth of formation _____
 Why _____
 Drillers Remarks: _____

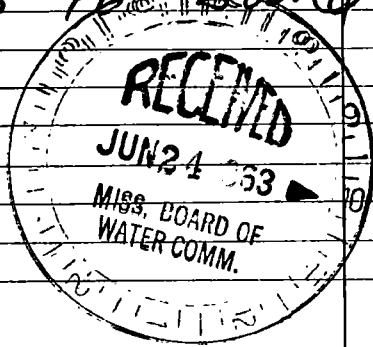

(Use Back Side)

Well No.

