

JACKSON MISSISSIPPI BOARD OF WATER COMMISSIONERS

N 150
11-8-62

WATER WELL DRILLERS LOG

Date: Nov. 8, 1962, Driller: M & B Drilling Co. County Jackson
55 (Name)

(1) Owner of Land: Gulf Coastal Air Land Co., Inc.
Old Highway 90 (Name) East St. Martin
School, Biloxi, Miss.
Lot #748, Block 16 (Address)
(2) Location: 1/4, 1/4, Sec. 15 T 8 R 9 W
3 miles NE, of Biloxi
(distance) (direction) (Nearest Town)
(3) Topography: Flat
(Hilly) (Flat) (Level)
(4) Purpose of Well: Domestic
(Domestic Irrigation
Municipal, Industrial, Other)


Description & Color of Materials Sand, Clay, Red Clay, Shell, etc.	Thick- ness Feet	Depth Feet
Clay	15	15
White Sand	10	25
Black Clay	35	60
Blue Clay	45	105
White Sand + old Swamp	60	165
Blue Clay	209	374
Grey Sand	20	394
Blue Clay	394-430	on

Information upon completion of well:

(1) Diameter 2 inches.
(2) Total Depth 390 feet.
(3) Water Level 3 feet below top of ground.
(4) Cased to 380, Size 2"
(5) Screen: Size 2" X 3/16", Length 10 FT.
(6) Were any formations sealed against pollution?
_____ yes, _____ no.

This sand at 105-165 had old wood, leaves, silt & a little of everything in it.
Took 600# of Mud & 5000 gallons of water to get thru it.

If YES depth of formation _____
Why _____
Drillers Remarks: _____

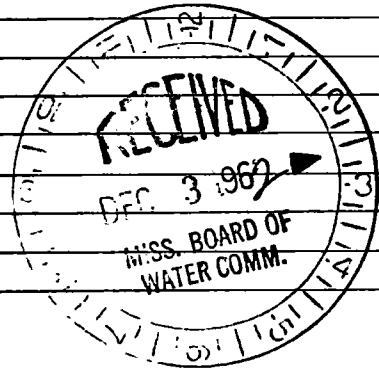

(Use Back Side)

Well No.

