

JACKSON MISSISSIPPI BOARD OF WATER COMMISSIONERS

N 155

3-7-63

WATER WELL DRILLERS LOG

Date: Mar. 7, 1963, Driller: L. L. Garland County Jackson
(Name)

(1) Owner of Land	Description & Color of Materials Sand, Clay, Red Clay, Shell, etc.	Thick- ness Feet	Depth Feet
<u>Pat Bunch</u> <small>(Name)</small> <u>O. S. Miss.</u> <small>(Address)</small>	1 <u>Mud & S.S.</u>		
(2) Location: <u>1/4</u> , <u>1/4</u> , Sec. <u>19</u> , T. <u>7</u> , R. <u>8</u> <u>1</u> miles <u>North</u> , of <u>O. S.</u> <small>(distance) (direction) (Nearest Town)</small>	2 <u>Sand & Gravel</u>		
(3) Topography: <u>Dom.</u> <small>(Hilly) (Flat) (Level)</small>	3 <u>14' S 7' M.</u>		
(4) Purpose of Well: <u>Dom.</u> <small>(Domestic Irrigation Municipal, Industrial, Other)</small>	4 <u>Mud</u>		
	5 <u>Mix.</u>		
	6 <u>"</u>		
	7 <u>"</u>		
	8 <u>Mud</u>		
	9 <u>"</u>		
	10 <u>Mix.</u>		
	11 <u>17' Mud 4' Sand</u>		
	12 <u>Mix.</u>		
	13 <u>"</u>		
	14 <u>"</u>		
	15 <u>14' F. Sand 7' M.</u>		
	16 <u>Mud</u>		
	17 <u>"</u>		
	18 <u>Mix.</u>		
	19 <u>"</u>		
	20 <u>Mud</u>		
	21 <u>Mix.</u>		
	22 <u>Sand</u>		
	23 <u>"</u>		

Information upon completion of well:

(1) Diameter 2 inches.

(2) Total Depth 483 feet.

(3) Water Level 14 feet below top of ground.

(4) Cased to _____, Size _____.


(5) Screen: Size .08, Length 10'.

(6) Were any formations sealed against pollution?
 _____ yes, _____ no.

If YES depth of formation _____

Why _____

Drillers Remarks: _____

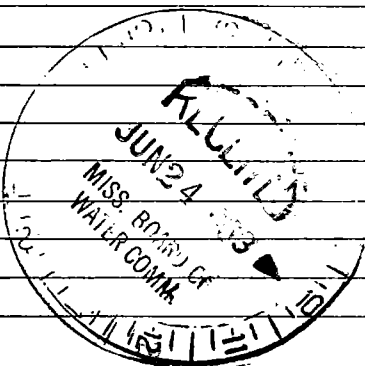

(Use Back Side)

Well No.

