

JACKSON MISSISSIPPI BOARD OF WATER COMMISSIONERS

N 157

4-12-63

WATER WELL DRILLERS LOG

Date: Apr. 12, 1963, Driller: L. L. Garland County Jackson
(Name)

(1) Owner of Land	Description & Color of Materials Sand, Clay, Red Clay, Shell, etc.	Thick- ness Feet	Depth Feet
<u>Jack McPherson</u> <small>(Name)</small> <u>O. S. Missi</u> <small>(Address)</small>	1 10' Mud 11' Sand		
(2) Location: <u>33 T. R. 8</u> <u>2</u> miles <u>EAST</u> of <u>O. S.</u> <small>(distance) (direction) (Nearest Town)</small>	2 Sand 3 Mix. 4 " 5 " 6 " 7 " 8 "		
(3) Topography: <u>Dom.</u> <small>(Hilly) (Flat) (Level)</small>	9 " 10 Mud		
(4) Purpose of Well: <u>Dom.</u> <small>(Domestic Irrigation Municipal, Industrial, Other)</small>	11 " 12 Mix. 13 " 14 Sand 15 Mix. 16 " 17 Mud 18 "		

Information upon completion of well:

(1) Diameter 2 inches.

(2) Total Depth 433 feet.

(3) Water Level 6 feet below top of ground.

(4) Cased to _____, Size _____.


(5) Screen: Size 08, Length 10'.

(6) Were any formations sealed against pollution?
 _____ yes, _____ no.

If YES depth of formation _____

Why _____

Drillers Remarks: _____

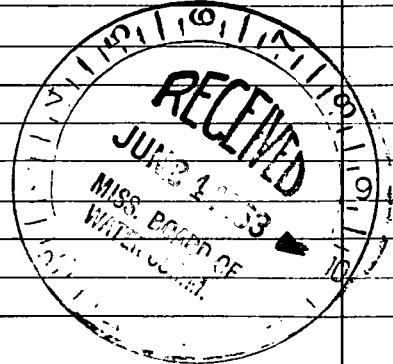

(Use Back Side)

Well No. _____

