

JACKSON MISSISSIPPI BOARD OF WATER COMMISSIONERS

N 158

4-16-63

WATER WELL DRILLERS LOG

Date: Apr. 16, 1963, Driller: L. L. Garland County Jackson

55

Mrs. A. Bear

(Name)

(1) Owner of Land: ~~Mr. A. Bear~~

O.S.

(Name)

(Address)

(2) Location: 33 7/8 ^W Sec. 33 T. 7 R. 8

3 East

(distance)

(direction)

of O.S. (Nearest Town)

(3) Topography:

(Hilly)

(Flat)

(Level)

(4) Purpose of Well: Dom.

(Domestic Irrigation
Municipal, Industrial, Other)

Information upon completion of well:

(1) Diameter 2 inches.

(2) Total Depth 441 feet.

(3) Water Level Flowed feet below top of ground.

(4) Cased to _____, Size _____

(5) Screen: Size 08, Length 10'

(6) Were any formations sealed against pollution?

_____ yes, _____ no.

If YES depth of formation _____

Why _____

Drillers Remarks: _____

Description & Color of Materials
Sand, Clay, Red Clay, Shell, etc.

Thick-
ness
Feet

Depth
Feet

1 Sand & Mud Strk

2 Mix.

3 11" Mud 10' Sand

4 Mix.

5 Sand

6 "

7 "

8 Mix.

9 "

10 "

11 Mud

12 Mix.

13 Mud

14 Mix.

15 "

16 "


17 "

18 "

19 "

20 19' Mud 2' Sand

21 Sand

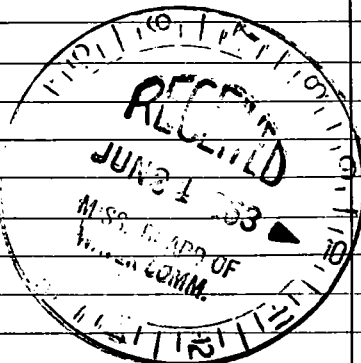

(Use Back Side)

Well No.

