

Jackson
N 161

MISSISSIPPI BOARD OF WATER COMMISSIONERS

7-1-63

WATER WELL DRILLERS LOG

Date: JULY 1, 1963, Driller: GEORGE W. COLVILLE County JACKSON

35

(Name)

(1) Owner of Land: ST. MARTIN CONSOL. SCHOOL (Name)
ST. MARTIN, MISS (Address)

(2) Location: 1/4, 1/4, Sec. 16 T25 R9W,
ST. MARTIN (Nearest Town)
 (distance) miles (direction)

(3) Topography: Level (Hilly) (Flat) (Level)

(4) Purpose of Well: SCHOOL (Domestic Irrigation Municipal, Industrial, Other)

Description & Color of Materials Sand, Clay, Red Clay, Shell, etc.	Thick-ness Feet	Depth Feet
CLAY	16	16
WHITE SAND	14	30
CLAY	58	88
SAND	12	100
CLAY	10	110
SAND	22	132
CLAY	44	176
SAND	22	198
CLAY	44	242
SAND	22	264
CLAY	186	450
SAND	12	462
CLAY	13	475
SAND	131	506
CLAY	282	788
SANDY CLAY	04	792
SAND	88	880

Information upon completion of well:

(1) Diameter 4x3 inches.

(2) Total Depth 880 feet.

(3) Water Level 6 feet ABOVE below top of ground.

(4) Cased to 8:45, Size 7 1/8-3" 100 #

(5) Screen: Size 3 in. 010, Length 40 #


(6) Were any formations sealed against pollution?

X yes, _____ no.

If YES depth of formation 30 #

Why CONTRACT CALLED FOR IT.

Drillers Remarks:

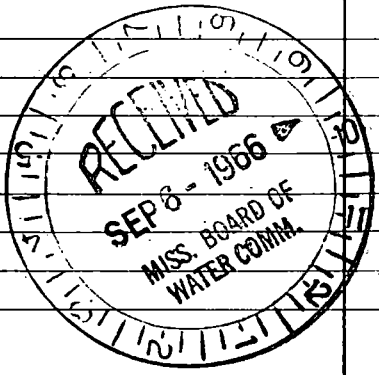

(Use Back Side)

Well No. 020

