

N 164
8-11-65

WATER WELL DRILLERS LOG

Date: 8-11, 1965, Driller: Sutter Well Wks. County Harrison
45 (Name) Jackson

(1) Owner of Land: W. A. Boon, Jr.
(Name)
Bilopi Miss.
(Address)

(2) Location: SE 1/4, SE 1/4, Sec. 10 T. 259 N
3 miles NE of Bilopi
(distance) (direction) (Nearest Town)

(3) Topography: hilly
(Hilly) (Flat) (Level)

(4) Purpose of Well: domestic
(Domestic Irrigation
Municipal, Industrial, Other)

Description & Color of Materials Sand, Clay, Red Clay, Shell, etc.	Thick- ness Feet	Depth Feet
<u>red sandy clay</u>	<u>18</u>	<u>18</u>
<u>Clay - sand streaks</u>	<u>111</u>	<u>129</u>
<u>fine sand</u>	<u>11</u>	<u>140</u>
<u>clay</u>	<u>150</u>	<u>290</u>
<u>sand</u>	<u>14</u>	<u>304</u>
<u>clay</u>	<u>109</u>	<u>413</u>
<u>sand</u>	<u>19</u>	<u>432</u>
<u>clay</u>	<u>58</u>	<u>490</u>
<u>fine sand</u>	<u>12</u>	<u>502</u>
<u>clay</u>	<u>51</u>	<u>553</u>
<u>sand</u>	<u>44</u>	<u>597</u>

Information upon completion of well:

(1) Diameter 2 inches.

(2) Total Depth 597 feet.

(3) Water Level 26 feet below top of ground.

(4) Cased to all, Size 2"


(5) Screen: Size 2", Length 16'

(6) Were any formations sealed against pollution?
no

If YES depth of formation _____

Why _____

Drillers Remarks: _____

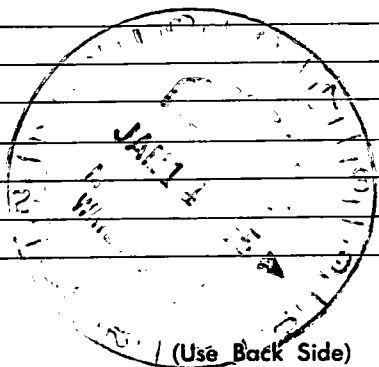

Well No.

