

N 166

4073

1-28-66

WATER WELL DRILLERS LOG

CODED

Date: 1-28, 1966, Driller: Sutter West Works County Harrison  
45 (Name) Jackson

(1) Owner of Land: W. A. Bann Jr.  
(Name)

Biloxi, Miss.  
(Address)

(2) Location: SE 1/4, SE 1/4, Sec. 10 T25R9E

3 miles NE of Biloxi  
(distance) (direction) (Nearest Town)

(3) Topography: Hilly  
(Hilly) (Flat) (Level)

(4) Purpose of Well: domestic  
(Domestic Irrigation  
Municipal, Industrial, Other)

Description & Color of Materials Sand, Clay, Red Clay, Shell, etc.	Thick- ness Feet	Depth Feet
Clay	35	35
Sand	19	54
Clay - sand streaks	226	280
Sand	21	301
Clay - sand streaks	113	414
Sand	16	430

Information upon completion of well:

(1) Diameter 2 inches.

(2) Total Depth 430 feet.

(3) Water Level 30 feet below top of ground.

(4) Cased to All, Size 2"

(5) Screen: Size 2", Length 10'

(6) Were any formations sealed against pollution?


yes, no.

If YES depth of formation

Why

Drillers Remarks:

CODED

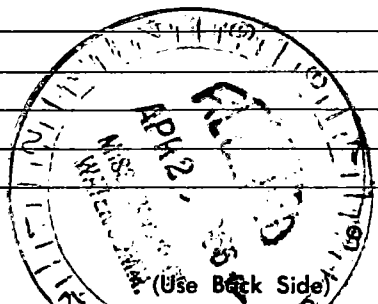

Well No.

RECORDED

1871

23

1871

11

1871

1871