

Jackson
N 176
12-66

MISSISSIPPI BOARD OF WATER COMMISSIONERS

WATER WELL DRILLERS LOG

Date: 12-7, 1966, Driller: C.T. Switzer Well Co. County Jackson
45 (When well drilled) (Name) (Where well is located)

1) Owner of Land: A. Van Ryan
 (Name)
Silson Road off Highway 90, E.
of Ocean Springs
 (Address)

2) Location: SE 1/4, NE 1/4, Sec. 25 T7 R8
5 miles E of Ocean Springs
 (distance) (direction) (Nearest Town)

3) Topography: X
 (Hilly) (Flat) (Level)

4) Purpose of Well: domestic
 (Domestic Irrigation
 Municipal, Industrial, Other)

Description & Color of Materials Sand, Clay, Red Clay, Shell, etc.	Thick- ness Feet	Depth Feet
Old well	0	67
Clay	67	132
Mixed	132	142
Clay	142	242
Mixed	242	265
Clay	265	287
Mixed	287	309
Soft clay	309	331
Mixed	331	374
Fine sand	374	396
Fair sand	396	424
Clay	424	457
Sand	457	460
Good sand	460	503

Information upon completion of well:

1) Diameter 2 inches.

2) Total Depth 503 feet.

3) Water Level 5 feet below top of ground.

4) Cased to 503', Size 2"

5) Screen: Size 8ga SS, Length 10'

6) Were any formations sealed against pollution?
X yes, _____ no.

YES depth of formation _____


by Health Dept. (Agments)

Drillers Remarks: _____

Yield in gpm: _____

Size pump: _____

Type power: _____

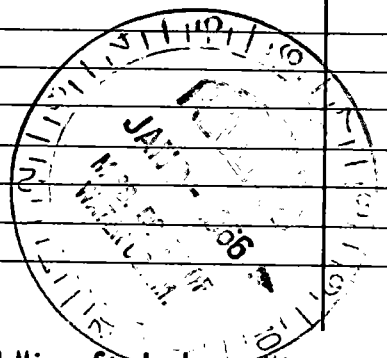

File this copy to Board of Water Commissioners 429 Miss. St. Jackson, Miss.

