

Jackson
N177
2-67

MISSISSIPPI BOARD OF WATER COMMISSIONERS

WATER WELL DRILLERS LOG

Date: Feb. 14, 1967, Driller: M+B Drilling Co. County Jackson
 45 (When well drilled) (Name) (Where well is located)


(1) Owner of Land: L. W. Bass
 (Name)
Vestry Rd Biloxi, Miss
 (Address)
 (2) Location: SW 1/4, NW 1/4, Sec 10 T25R9W
4 miles North, of Biloxi
 (distance) (direction) (Nearest Town)
 (3) Topography: Flat
 (Hilly) (Flat) (Level)
 (4) Purpose of Well: Domestic
 (Domestic Irrigation Municipal, Industrial, Other)

Description & Color of Materials Sand, Clay, Red Clay, Shell, etc.	Thick- ness Feet	Depth Feet
Surface Clay	6	6
Sand (white)	8	14
Clay	4	18
Grey Clay	18	36
Sand & Small Gravel	21	57
Blue Clay	63	120
Sand	25	145
Blue Clay	45	190
Sand	7	197
Blue Clay	33	230
Sand (Grey)	7	237
Blue Clay	23	260
Grey Sand	28	288

Information upon completion of well:
105 FT 4", Balance 2"
 (1) Diameter _____ inches.
 (2) Total Depth 280 feet.
 (3) Water Level 33 feet below top of ground.
 (4) Cased to 280 FT, Size 4X2
 (5) Screen: Size 2" X 8 1/2", Length 15 FT.
 (6) Were any formations sealed against pollution?
 _____ yes, _____ no.

Still cutting sand when drilling stopped

If YES depth of formation _____
 Why _____
 Drillers Remarks: _____
 Yield in gpm: 20
 Size pump: 1 HP. Submersible 8 Stage
 Type power: 220 Volt 1φ

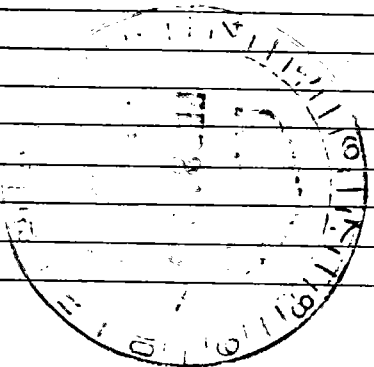

(b) (5) - ACP
The
top