

45

Jackson
N178
3-67

MISSISSIPPI
BOARD OF WATER COMMISSIONERS
416 North State Street
Jackson, Mississippi 39201

WATER WELL DRILLERS LOG

Jackson
Harrison
county well located

3-23, 1967 date well completed
Switzer Well Co. firm name

LANDOWNER: Charles Janner
One block N. intersection of
old Highway 90 + Tucker Rd.
Rt. 3 Box 335 Biloxi
(mailing address)


WELL LOCATION:
sec. 12 T 7 S R 9 W
2 miles NW of OCEAN SPRING
(distance) (direction) (nearest town)

WELL PURPOSE: Home
(home, irrigation, municipal, industrial)

WELL COMPLETION DATA:

- (1) diameter (inches) 2
- (2) total depth (feet) 451
- (3) static water level (feet) 12 below top of ground
- (4) casing gal. steel 441' (material) (depth)
2" (size) if telescope see back.
- (5) screen 10' (length) 441' (depth to top)
2" (size) 10ga SS on pipe (material)
- (6) pump 1/3 (HP) 5 (yield gpm)
electric (type power)
- (7) electric log No (yes or no)
(organization running log)
- (8) how well bottom plugged back pressure valve

description of formations encountered	from	to
sand	0	13
clay	13	29
sand	29	43
coarse white sand gravel	43	62
sand + gravel	62	75
soft clay	75	115
fine blue sand	115	138
clay	138	185
sand	185	193
clay	193	197
mixed sand + clay	197	207
hard clay	207	246
sand	246	247
clay	247	248
clay + sand streaks	248	258
clay	258	401
good sand	401	453

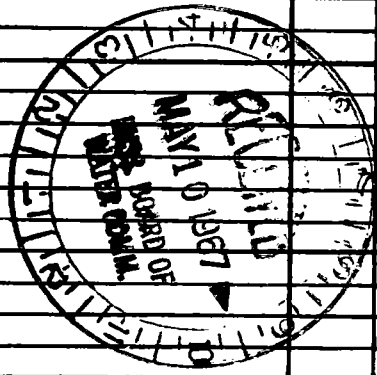


DRILLERS REMARKS:

If well telescopes please sketch and show depths.

SW SE

GROUND LEVEL

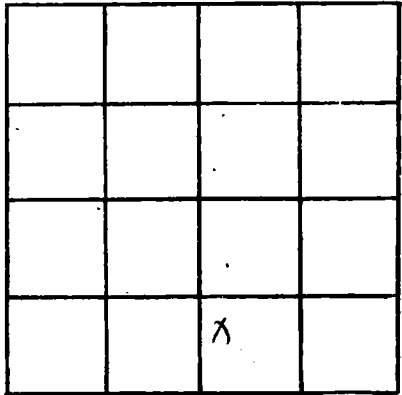

SECTION 12

Please indicate well location X.

ADDITIONAL INFORMATION

Lined area for additional information.

If more than one screen, show locations of each on sketch.