

45

MISSISSIPPI
 BOARD OF WATER COMMISSIONERS
 416 North State Street
 Jackson, Mississippi 39201

WATER WELL DRILLERS LOG

Jackson
 N 179
 3-67

3-17 1967
 date well completed

Switzer Well Co.
 firm name

Jackson
 county well located

LANDOWNER: Clarence Crossley
 Old Highway 90, 1/2 mi. E. of
 St. Martin School
 Rt 3 Box 434, Biloxi, Miss.
 (mailing address)

description of formations encountered	from	to
sand	0	30
clay	30	114
fine sand	114	123
brnd, okay	123	144
good sand	144	179

WELL LOCATION:
 sec. 15 T 7 R 9
 S W
 3 miles NE of Biloxi
 (distance) (direction) (nearest town)

WELL PURPOSE: Home
 (home, irrigation, municipal, industrial)

WELL COMPLETION DATA:

- (1) diameter (inches) 2
- (2) total depth (feet) 179
- (3) static water level (feet) 11 below top of ground
- (4) casing gal. steel 169' (material) (depth)
 2" (size) if telescope see back.
- (5) screen 10' (length) 169' (depth to top)
 2" (size) 8ga. ss. on pipe (material)
- (6) pump not installed (HP) (yield gpm)
- (type power)
- (7) electric log No (yes or no)
 (organization running log)
- (8) how well bottom plugged back pressure valve


DRILLERS REMARKS:



If well telescopes please sketch and show depths.

GROUND LEVEL

SW NW

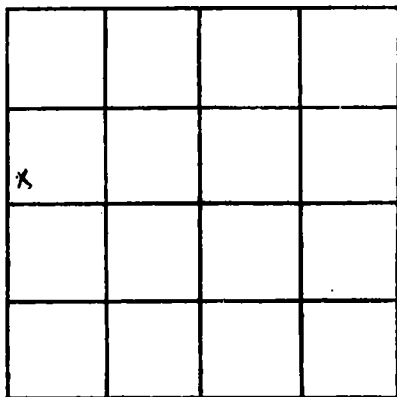

SECTION 15

Please indicate well location X.

ADDITIONAL INFORMATION

If more than one screen, show locations of each on sketch.